

HAR.

MISSISSIPPI BOARD OF WATER COMMISSIONERS

A22 m521702

1-4-61

WATER WELL DRILLERS LOG

CODED

Date: 1-4, 1961, Driller: J. Bevis, County: Harrison

(Name)

(1) Owner of Land: Virgil Howard

(Name)

RT 1 # 37 Aucun Min

(Address)

(2) Location: Mutton Ridge H T 5 R 3

1/4, 1/4, Sec.

8 miles West of Lizaona

(distance), (direction), (Nearest Town)

(3) Topography: (Hilly) (Flat) (Level)

(4) Purpose of Well: Home

(Domestic Irrigation, Municipal, Industrial, Other)

Description & Color of Materials Sand, Clay, Red Clay, Shell, etc.	Thick- ness Feet	Depth Feet
15 ft Red Clay		15-
80 ft Sand		95-
70" soft Blue Clay	1	60-
100 ft Hard Blue Clay	2	60-
45 ft with strutton		45-
Total	3	10

Information upon completion of well:


- (1) Diameter 2" x 1/4" inches.
- (2) Total Depth 310 feet.
- (3) Water Level 60 feet below top of ground.
- (4) Cased to _____, Size _____.
- (5) Screen: Size _____, Length _____.
- (6) Were any formations sealed against pollution?

yes, no.

If YES depth of formation _____

Why _____

Drillers Remarks: _____

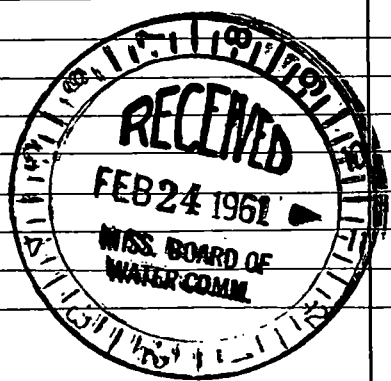

(Use Back Side)

Well No.

