

HARRISON
A 25
8-10-72

MISSISSIPPI
 BOARD OF WATER COMMISSIONERS
 416 North State Street
 Jackson, Mississippi 39201

WATER WELL DRILLERS LOG **CODED**

August 10, 1972, Ladwiera's Well Works HARRISON
 date well completed firm name county well located

LANDOWNER: Mr. Russell Reid
Highway 53
Lizana, Miss.
 (mailing address)

description of formations encountered	from	to
<u>Red Clay</u>	<u>0</u>	<u>40</u>
<u>Red Sand & Clay</u>	<u>40</u>	<u>90</u>
<u>Blue Sand Clay</u>	<u>90</u>	<u>150</u>
<u>Blue Clay Sand</u>	<u>150</u>	<u>505</u>

WELL LOCATION:
 sec. 4 T. 5 R. 13
10 miles NorthWest of Saucier
 (distance) (direction) (nearest town)

WELL PURPOSE: HOME
 (home, irrigation, municipal, industrial)

WELL COMPLETION DATA:
 (1) diameter (inches) 4 inch ^{top}
 (2) total depth (feet) 2 1/2 ~~12.5~~ ^{bottom}
 (3) static water level (feet) 90 below above
 top of ground.
 (4) casing All Plastic, 505 ft.
 (material) (depth)
2 1/4 inch If telescope see back.
 (size)
 (5) screen 20 ft., 505 ft.
 (length) (depth to top)
2 inch, S.S.
 (size) (material)
 (6) pump 3/4 ^{submerged} 20
 (HP) (yield gpm)
Elect.
 (type power)
 (7) electric log No
 (yes or no)
 (organization running log)

(8) how well bottom plugged Ball Check


DRILLERS REMARKS:



NOV 2 1972

If well telescopes please sketch and show depths.

GROUND LEVEL

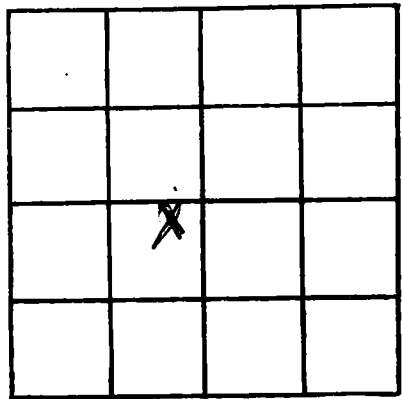

SECTION 21

Please indicate well location X.

ADDITIONAL INFORMATION

If more than one screen, show locations of each on sketch.