

Harrison
 A 26
 9-73

MISSISSIPPI
 BOARD OF WATER COMMISSIONERS
 416 North State Street
 Jackson, Mississippi

CODED

WATER WELL DRILLERS LOG

date well completed 19 73 Mc Gill Well Works firm name Harrison county well located

| LANDOWNER: <u>Hattie Vance</u> | description of formations encountered | from | to |
|---|--|-----------|------------|
| <u> Rt. 2 Box 159</u> | | | |
| <u> Sulfost Miss</u> (mailing address) | <u> clay</u> <u> fine sand</u> <u> sand - gravel</u> | <u> 0</u> | <u> 64</u> |
| WELL LOCATION: | | | |
| sec <u> 25</u> T <u> 5</u> N R <u> 13</u> E | | | |
| <u> 22</u> miles <u> SW</u> of <u> Sulfost</u> (distance) (direction) (nearest town) | | | |
| WELL PURPOSE: <u> None</u> (home, irrigation, municipal, industrial) | | | |
| WELL COMPLETION DATA: | | | |
| (1) diameter (inches) <u> 2 "</u> | | | |
| (2) total depth (feet) <u> 140 '</u> | | | |
| (3) static water level (feet) <u> 32 '</u> <u> below</u> above top of ground. | | | |
| (4) casing <u> plastic</u> <u> 130 '</u> (material) (depth) | | | |
| _____ if telescope see back. (size) | | | |
| (5) screen <u> 10 '</u> (length) (depth to top) | | | |
| <u> 2 "</u> <u> plastic</u> (size) (material) | | | |
| (6) pump <u> 1</u> <u> 9</u> (HP) (yield gpm) | | | |
| <u> electric</u> (type power) | | | |
| (7) electric log <u> No</u> (yes or no) | | | |
| _____ (organization running log) | | | |
| (8) how well bottom plugged <u> sand</u> <u> streak</u> | | | |


CODED

SEP 10 1973

DRILLERS REMARKS:

If well telescopes please sketch and show depths.

GROUND LEVEL

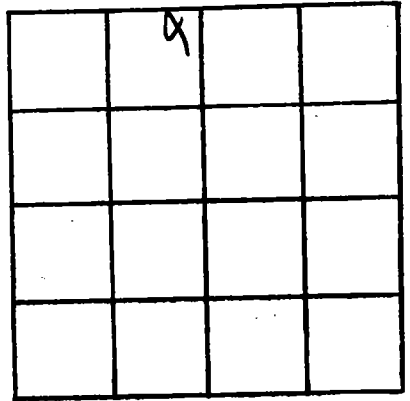

SECTION 25

Please indicate well location X.

ADDITIONAL INFORMATION

If more than one screen, show locations of each on sketch.