

HARRISON
A29
4-10-74

MISSISSIPPI
BOARD OF WATER COMMISSIONERS
416 North State Street
Jackson, Mississippi 39201

CODED

WATER WELL DRILLERS LOG

4-10 1974 Darnell Anderson Harrison
date well completed firm name county well located

LANDOWNER:
Dicky Ladiner
Rt 1 Saucier
(mailing address)

description of formations encountered	from	to
Top Soil	0	3
Red Clay	3	28
White Clay	28	55
Blue Clay	55	180
Coarse Sand	180	198

WELL LOCATION:
sec 16 T 5 S R 13 E
20 miles SW of Park
(distance) (direction) (nearest town)

WELL PURPOSE: HOME
(home, irrigation, municipal, industrial)

WELL COMPLETION DATA:

(1) diameter (inches) 2"

(2) total depth (feet) 198'

(3) static water level (feet) 110' below above top of ground

(4) casing Plastic 105'
(material) (depth)

(size) If telescope see back.

(5) screen 5' 105'
(length) (depth to top)

8" Plastic
(size) (material)

(6) pump 1 ~~5~~ 5'
(HP) (yield gpm)


Elect
(type power)

(7) electric log NO
(yes or no)

(organization running log)

CODED

(8) how well bottom plugged
Backwash valve

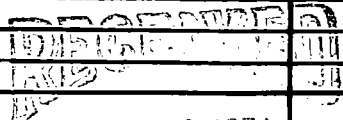

DRILLERS REMARKS:

MAY 16 1974

If well telescopes please sketch and show depths.

GROUND LEVEL

SECTION _____

Please indicate well location X.

ADDITIONAL INFORMATION

If more than one screen, show locations of each on sketch.