

HARRISON

A 30

11-13-73

MISSISSIPPI BOARD OF WATER COMMISSIONERS 416 North State Street Jackson, Mississippi 39201

WATER WELL DRILLERS LOG

Nov 13 1973 Mc Hill Well Works Harrison date well completed firm name county well located

LANDOWNER: LeRay Sadler Jr

Rt. 1 Box 547-B

Las Christian, Miss (mailing address)

WELL LOCATION:

sec 20 T 5 N R 13 E S W 26 miles West of Lumberton (distance) (direction) (nearest town)

WELL PURPOSE: Domestic (home, irrigation, municipal, industrial)

WELL COMPLETION DATA:

- (1) diameter (inches) 2"
(2) total depth (feet) 305
(3) static water level (feet) 58 below top of ground
(4) casing gal. 295 (material) (depth)
(5) screen 10' (length) (depth to top) 2" (size) SS (material)
(6) pump 1 (HP) 8 (yield gpm) electric (type power)
(7) electric log No (yes or no)
(8) how well bottom plugged sand shale


Table with 3 columns: description of formations encountered, from, to. Entries include clay, fine sand, blue clay, silt, clay, sand, coarse sand.

CODED

DRILLERS REMARKS:

If well telescopes please sketch and show depths.

GROUND LEVEL

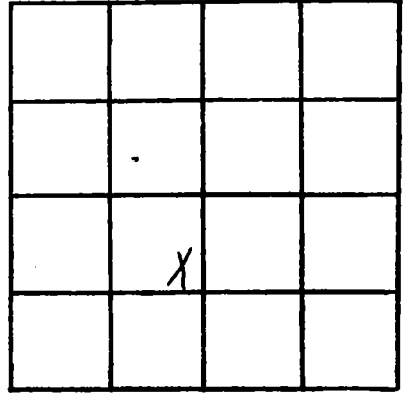

SECTION 20

Please indicate well location X.

ADDITIONAL INFORMATION

If more than one screen,
show locations of each on sketch.