

HARRISON
A 32
1-12-74

MISSISSIPPI
 BOARD OF WATER COMMISSIONERS CODED
 416 North State Street
 Jackson, Mississippi 39201

WATER WELL DRILLERS LOG

Jan 12 1974 McHill Well Works Harrison
 date well completed firm name county well located

LANDOWNER:
Wiley Woodcock Jr.
Rt. 1 Pass Christian
Box 205 (mailing address)

WELL LOCATION:
 sec. 19 T. 5 N. R. 18 E.
6 miles S.W. of Riceville
 (distance) (direction) (nearest town)

WELL PURPOSE: home
 (home, irrigation, municipal, industrial)

WELL COMPLETION DATA:

(1) diameter (inches) 2"

(2) total depth (feet) 304'

(3) static water level (feet) 87' below top of ground

(4) casing 2" PVC 294'
 (material) (depth)

— If telescope see back.
 (size)

(5) screen 10" 294'
 (length) (depth to top)

2" S.S.
 (size) (material)

(6) pump 1 8
 (HP) (yield gpm)

Electric
 (type power)

(7) electric log no
 (yes or no)

—
 (organization running log)

description of formations encountered	from	to
clay	0	47
sand	47	91
blush	91	149
blue clay	149	211
red sand	211	251
blue clay	251	288
chance sand	288	304

CODED

DISCOVERED
 DISCOVERED

JAN 21 1975


MRS. J. J. ... COMM

(8) how well bottom plugged sand shack
Back wash valve

DRILLERS REMARKS:

If well telescopes please sketch and show depths.

GROUND LEVEL

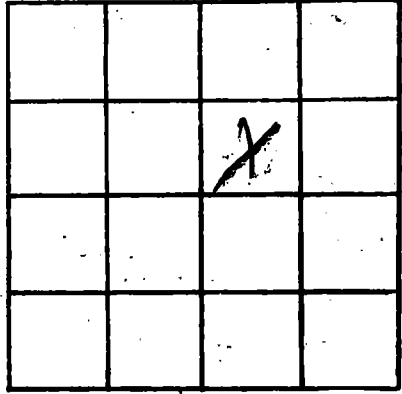

SECTION 19

Please indicate well location X.

ADDITIONAL INFORMATION

If more than one screen, show locations of each on sketch.