

**HARRISON**  
**A 34**  
**4-13-75**

MISSISSIPPI  
 BOARD OF WATER COMMISSIONERS  
 416 North State Street  
 Jackson, Mississippi 39201

**CODED**

**WATER WELL DRILLERS LOG**

4-13 1975 Parrell Anderson Drillers  
 date well completed firm name county well located


LANDOWNER:	description of formations encountered	from	to
<u>Robert Ladner</u>			
(mailing address)	<u>Red sand</u>	<u>4</u>	<u>24</u>
WELL LOCATION:	<u>Fin sand</u>	<u>84</u>	<u>108</u>
sec. <u>17</u> T. <u>5</u> S. R. <u>13</u> E. W. <u>2</u>	<u>Coarse sand</u>	<u>100</u>	<u>124</u>
<u>2</u> miles <u>S</u> of <u>Reverie</u>			
(distance) (direction) (nearest town)			
WELL PURPOSE: <u>HOME</u>			
(home, irrigation, municipal, industrial)			
WELL COMPLETION DATA:			
(1) diameter (inches) <u>8"</u>			
(2) total depth (feet) <u>124'</u>			
(3) static water level (feet) <u>64'</u> below top of ground			
(4) casing <u>Plastic, 119'</u>			
(material) (depth)			
(size) If telescope see back.			
(5) screen <u>5" 119'</u>			
(length) (depth to top)			
<u>2" Plastic</u>			
(size) (material)			
(6) pump <u>1</u> <u>9</u>			
(HP) (yield gpm)			
<u>Elect</u>			
(type power)			
(7) electric log <u>no</u>			
(yes or no)			
(organization running log)			
(8) how well bottom plugged <u>Plugged</u>			
DRILLERS REMARKS:			

**RECEIVED**  
 MAY - 8 1975

MISS. BB. OF WATER COMMISSIONERS

If well telescopes please sketch and show depths.

GROUND LEVEL

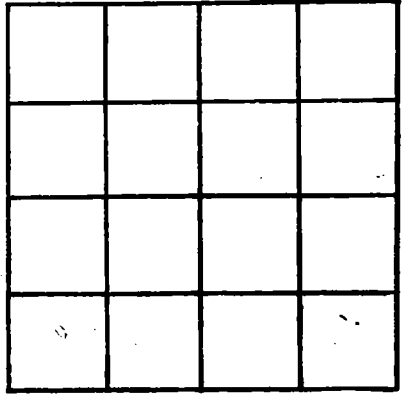

SECTION \_\_\_\_\_

Please indicate well location X.

ADDITIONAL INFORMATION

If more than one screen, show locations of each on sketch.