

**HARRISON**  
**A 35**  
**4-23-75**

MISSISSIPPI  
 BOARD OF WATER COMMISSIONERS  
 416 North State Street  
 Jackson, Mississippi 39201

**CODED**

**WATER WELL DRILLERS LOG**

4-23 1975 Parrell Anderson Harrison  
 date well completed firm name county well located

LANDOWNER:  
Robert Shaw  
 (mailing address)

description of formations encountered	from	to
<u>Top Soil</u>	<u>0</u>	<u>4</u>
<u>Pink Clay</u>	<u>4</u>	<u>18</u>
<u>Hard Sand</u>	<u>18</u>	<u>58</u>

WELL LOCATION:  
 sec. 6 T. 5 S. R. 13 E.  
2 miles N of Acville  
 (distance) (direction) (nearest town)

WELL PURPOSE: HOME  
 (home, irrigation, municipal, industrial)

WELL COMPLETION DATA:

(1) diameter (inches) 2"

(2) total depth (feet) 58'

(3) static water level (feet) 47' below top of ground.

(4) casing Plastic 53'  
 (material) (depth)

(size) If telescope see back.

(5) screen 3' 53'  
 (length) (depth to top)

2" Plastic  
 (size) (material)

(6) pump 1 4  
 (HP) (yield gpm)

Elect  
 (type power)

(7) electric log no  
 (yes or no)

(organization running log)

(8) how well bottom plugged Plugged

DRILLERS REMARKS:  
Well went very good


**RECEIVED**

APR - 8 1975

MISS. BD. OF WATER COMMISSIONERS

If well telescopes please sketch and show depths.

GROUND LEVEL

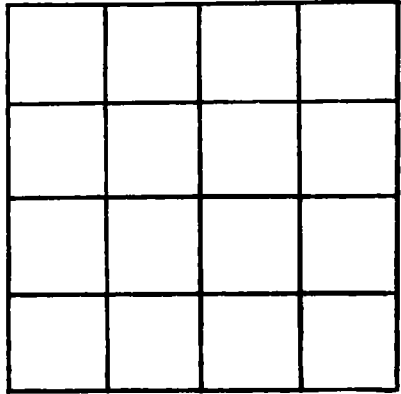

SECTION \_\_\_\_\_

Please indicate well location X.

ADDITIONAL INFORMATION

A series of horizontal lines providing space for additional information.

If more than one screen, show locations of each on sketch.