

MISSISSIPPI DEPARTMENT OF NATURAL RESOURCES

Bureau of Land and Water Resources

Southport Mall

P.O. Box 10631

Jackson, Mississippi 39209

WATER WELL DRILLERS LOG

COASTAL DRILLING & SERVICE CO.

CODED

HARRISON
A 39
7-9-79

7/9/79 date well completed
19 ROUTE 1 BOX 118 name
Biloxi, MISS 39532 county well located Harrison

LANDOWNER: William W. Harrison
Leomin Rd
Samuel Min
(mailing address)

description of formations encountered	from	to
topsoil	1	3
Red Clay	3	15
Coarse white sand	15	45
Soft Blue Clay	45	90
Coarse white sand	90	120
Soft Blue Clay	120	230
fine white sand	230	245
Hard Blue Clay	245	290
fine white sand	290	310
Good water sand	310	330

WELL LOCATION:
sec 13 T S N R 13 E
Fittler Biloxi River
(distance) miles (direction) of (nearest town)

WELL PURPOSE: home
(home, irrigation, municipal, industrial)

WELL COMPLETION DATA:

(1) diameter (inches) 4 1/2"

(2) total depth (feet) 330'

(3) static water level (feet) 20' below above top of ground

(4) casing PVC 315'
(material) (depth)
4 1/2" if telescope see back.
(size)

(5) screen 15' 315'
(length) (depth to top)
2" PVC
(size) (material)

(6) pump None 20
(HP) (yield gpm)
Ele
(type power)

(7) electric log no
(yes or no)

(organization running log)

(8) how well bottom plugged:
2" bed with valve

DRILLERS REMARKS: 19-B

DEPT. OF NATURAL RESOURCES
BUREAU OF LAND & WATER RESOURCES

NOV - 8 1980

RECEIVED

If well telescopes please sketch and show depths.

GROUND LEVEL

160' 4" PVC casing


155' 2" PVC casing

15' 2" PVC screen

2" lock wash valve

19-B

If more than one screen, show locations of each on sketch.

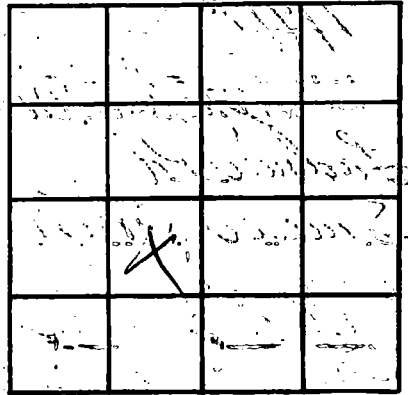

SECTION _____

Please indicate well location X.

ADDITIONAL INFORMATION

Multiple horizontal lines for additional information.