

MISSISSIPPI DEPARTMENT OF NATURAL RESOURCES

Bureau of Land and Water Resources

Southport Mall

P.O. Box 10631

Jackson, Mississippi 39209

WATER WELL DRILLERS LOG

CODED

Lyman Well Co. Harrison

A40  
HARRISON  
2-2-83

2/2/83  
date well completed

firm name

county well located

LANDOWNER: James Kilpatrick  
Herman Lachner Rd  
Lizana  
(mailing address)

description of formations encountered	from to	
fine sand & white clay	0	50
fine red sand & red clay	50	130
Gumbo Blue Clay	130	194
fine sand & pepper sand	194	248
Blue Clay	248	300
fine sand	300	358
Blue Clay	358	380
Good Sand	380	447

WELL LOCATION:

sec. 26 T. 5 N R. 13 E  
25 miles NW of Gpt  
(distance) (direction) (nearest town)

WELL PURPOSE: home  
(home, irrigation, municipal, industrial)

WELL COMPLETION DATA:

- (1) diameter (inches) 4 x 2
- (2) total depth (feet) 447'
- (3) static water level (feet) 106 below top of ground.
- (4) casing PVC, 437 (material), (depth)
- (size) If telescope see back.
- (5) screen 10', 437 (length), (depth to top)
- 2" PVC (size), (material)
- (6) pump 1 (HP), 34 (yield gpm)
- Electric (type power)
- (7) electric log No (yes or no)
- NO (organization running log)
- (8) how well bottom plugged sand Shark

DRILLERS REMARKS:



DEPT. OF NATURAL RESOURCES  
BUREAU OF LAND & WATER RESOURCES

MAY 11 1984

RECEIVED

If well telescopes please sketch and show depths.

GROUND LEVEL

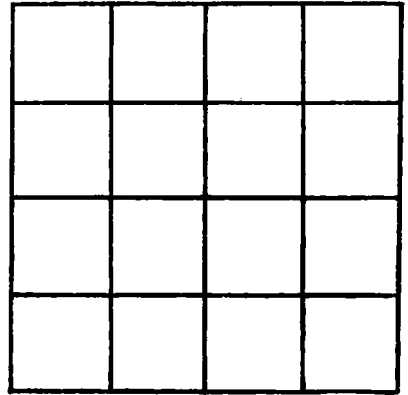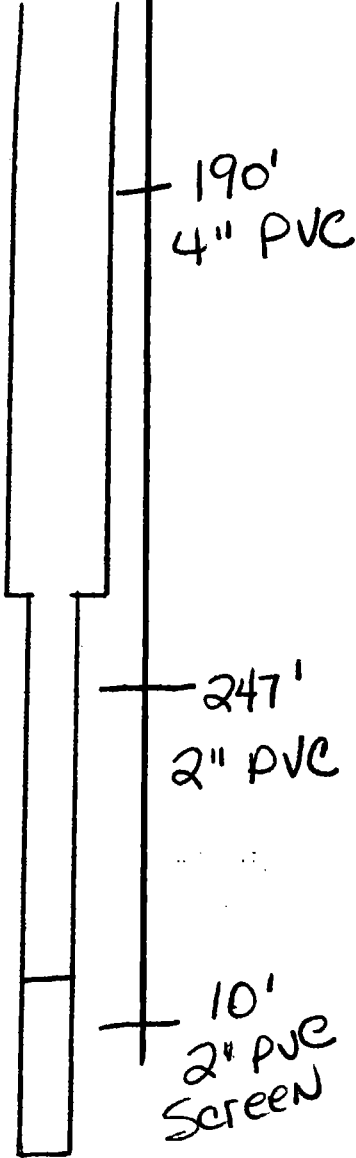

SECTION \_\_\_\_\_

Please Indicate well location X.

ADDITIONAL INFORMATION

If more than one screen, show locations of each on sketch.