

MISSISSIPPI DEPARTMENT OF NATURAL RESOURCES

Bureau of Land and Water Resources

Southport Mall

P.O. Box 10631

Jackson, Mississippi 39209

WATER WELL DRILLERS LOG

A4
 HARRISON
 2-5-83

CODED

2/5/83 19 Lyman Well Co. Harrison
 date well completed firm name county well located

LANDOWNER: Pete Natale
Rt. 1, Box 510
Saucier 39574
 (mailing address)

description of formations encountered	depth	
	from	to
<u>Red Clay & Gravel Sand</u>	<u>0</u>	<u>60</u>
<u>White & Gray Gumbo</u>	<u>60</u>	<u>125</u>
<u>Hard Blue Clay</u>	<u>125</u>	<u>173</u>
<u>fine Sand</u>	<u>173</u>	<u>200</u>
<u>Blue Clay</u>	<u>200</u>	<u>279</u>
<u>Good Sand</u>	<u>279</u>	<u>308</u>

WELL LOCATION:
 sec. 34 T. 5 N R. 12 E
16 miles NW of Gpt
 (distance) (direction) (nearest town)

WELL PURPOSE: Home
 (home, irrigation, municipal, industrial)

WELL COMPLETION DATA:

(1) diameter (inches) 4 x 2

(2) total depth (feet) 318

(3) static water level (feet) 70 below above top of ground.

(4) casing PVC, 308'
 (material) (depth)
 (size) if telescope see back.

(5) screen 10', 308'
 (length) (depth to top)
2", PVC
 (size) (material)

(6) pump 1, 34
 (HP) (yield gpm)
Electric
 (type power)

(7) electric log NO
 (yes or no)
NO
 (organization running log)

(8) how well bottom plugged sand
shark


DEPT. OF NATURAL RESOURCES
 BUREAU OF LAND & WATER RESOURCES

MAY 11 1984

RECEIVED

DRILLERS REMARKS:

If well telescopes please sketch and show depths.

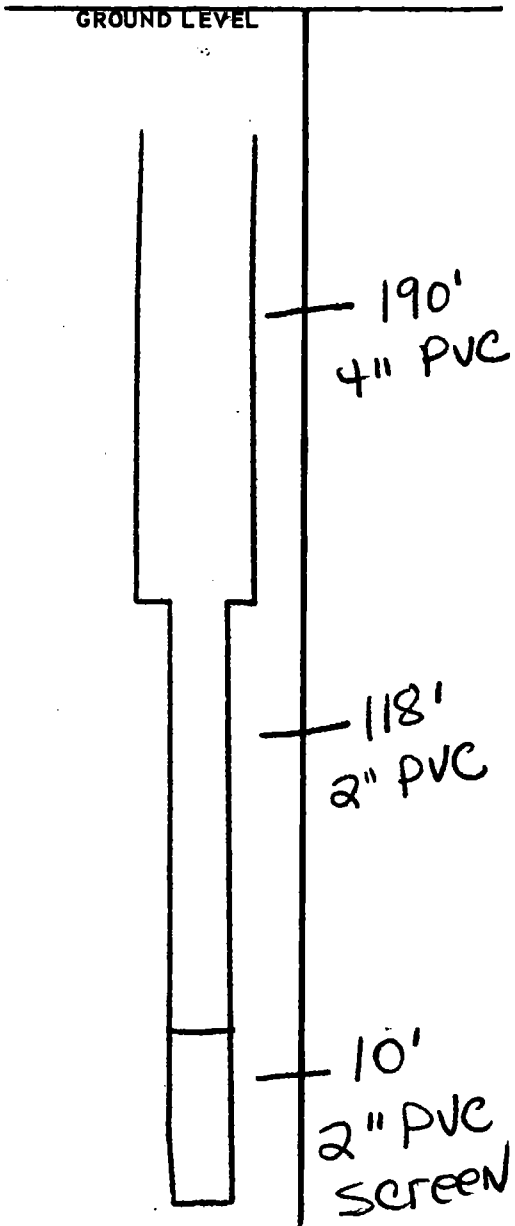

SECTION _____

Please indicate well location X.

ADDITIONAL INFORMATION

If more than one screen, show locations of each on sketch.