

MISSISSIPPI DEPARTMENT OF NATURAL RESOURCES

Bureau of Land and Water Resources

Southport Mall

P.O. Box 10631

Jackson, Mississippi 39209

WATER WELL DRILLERS LOG

CODED

A 43
Harrison
11-2-84

11/2/84
date well completed

Lyman Well Co.
firm name

Harrison
county well located

LANDOWNER: James Williams
Rt. 1, Box 404
Lauderdale, MS 39574
(mailing address)

description of formations encountered

from to
0 40

mud

sand

40 70

CODED

WELL LOCATION:

sec. 34 T. 5 N R. 13 E
13 miles N of Apt
(distance) (direction) (nearest town)

WELL PURPOSE: home
(home, irrigation, municipal, industrial)

WELL COMPLETION DATA:

- (1) diameter (inches) 2
- (2) total depth (feet) 70'
- (3) static water level (feet) 5 below above top of ground.
- (4) casing PVC 50'
(material) (depth)
2" (size) if telescope see back.
- (5) screen 20' 50'
(length) (depth to top)
2" PVC
(size) (material)
- (6) pump 1 (HP) (yield gpm)
electric (type power)
- (7) electric log NO (yes or no)
NO (organization running log)
- (8) how well bottom plugged sand Shark

DEPT. OF NATURAL RESOURCES
BUREAU OF LAND & WATER RESOURCES


DEC 17 1984

RECEIVED

DRILLERS REMARKS:

If well telescopes please sketch and show depths.

GROUND LEVEL

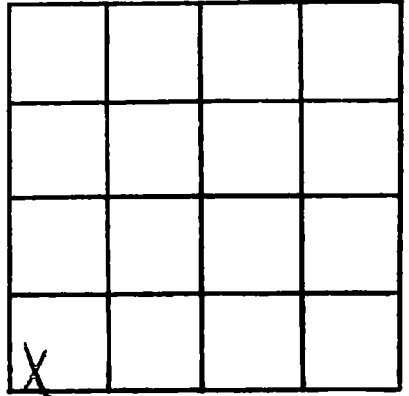

SECTION 34

Please indicate well location X.

ADDITIONAL INFORMATION

If more than one screen, show locations of each on sketch.