

MISSISSIPPI DEPARTMENT OF NATURAL RESOURCES

Bureau of Land and Water Resources

Southport Mall

P.O. Box 10631

Jackson, Mississippi 39209

WATER WELL DRILLERS LOG

CODED

HARRISON
A 44

12-21-85

date well completed

McNell Pump & Well

firm name

3 miles north of Bogalusa

county well located

HARRISON

LANDOWNER: Donna Uche

description of formations encountered

from

to

Rt. 1 Box 258

Daucier, Miss. 39574

(mailing address)

WELL LOCATION:

sec 28 T 5 N R 13 E
3 miles North of Bogalusa

WELL PURPOSE: home
(home, irrigation, municipal, industrial)

WELL COMPLETION DATA: 200-4"
260-2"

(1) diameter (inches) 4 1/2

(2) total depth (feet) 460'

(3) static water level (feet) 85 below top of ground

(4) casing ocb 40' 440'
(material) (depth)

(size) If telescope see back.

(5) screen 20' 440'
(length) (depth to top)

2" ocb 80 lead
(size) (material)

(6) pump 1/2 HP 25
(HP) (yield/gpm)

elec
(type power)

Electric log (yes or no)

(organization running log)

(8) how well bottom plugged Seal

DRILLERS REMARKS:

Department of Natural Resources
Bureau of Land & Water Resources


CODED

RECEIVED

MAR 6 - 1986

If well telescopes please sketch and show depths.

GROUND LEVEL

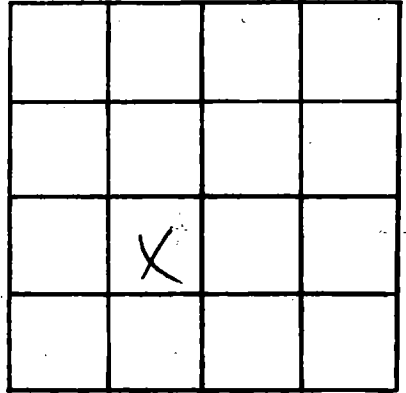

SECTION _____

Please indicate well location X.

ADDITIONAL INFORMATION

If more than one screen,
show locations of each on sketch.