
County: HATTISON Permit #: Drille: DASTUA LETUELSEN Date drilling completed: 1/14/11 State Law requires that this report be prepared by the 30 days of completion of drilling of the well. Well Owner Information	Well Location			
Owner Name <u>Clayton Homes Dan Cuevas</u> Mailing Address: <u>Herman Ladrer Rd</u> . <u>Saucier, Ms 39574</u> City <u>State</u> Zip Code Telephone No. <u>208) 831-8088</u>	Latitude: 30 • 34 · 49.44 Longitude 81 • 16 34.570" Method of Lat/Long (circle one): Conventional Survey, USGS quad, Hand-held GPS Survey-grade GPS <u>ME 1/4 SE 1/4 Sec 27 Twn 755 Rng 8.370</u> Distance Direction Nearest Town <u>15 Miles Mont Hof Cost Charsettors</u>			
Weil Data				
Purpose of Well (circle one) Home Industrial Public Supply Date well drilling started: Date w If flowing, method of flow regulation: Valve N/AOther (de Static Water Level: feet above of below (circle one) la Method of Measurement (circle one) steel tape electric tape Hole depth: FT_ Well depth: (G FT_ Type of grout (circle one): Cement Bentonite Mix Casing length: feet Casing diameter: Screen length: feet Screen diameter: Screen slot size: OD( inches Setting depth: From Type of completion (circle all applicable): Gravel packed Underr	rell drilling completed: escribe) and surface Date measured: air line other: Well grouted to a depth of feet  unches Type of casing: PVC feet to feet reamed Telescoped Open hole Natural Development			
Top of lap pipe or reduction in casing: $N/A$ feet. If tele Logs run (circle all applicable): No log run Electric Gamma Ray Name of organization running log(s): $N/A$ I certify that the well was drilled, constructed, and completed in a	ccordance with all applicable requirements of the Mississippi			
Department of Environmental Quality and/or the Mississippi Dep <u>Jack Ridgdell</u> 0-478 Print Name of Water Well Contractor and License No.	artment of Health regulations and state laws.			

vis Printing, Pascagoula, MS

A88

If well telescopes please sketch below and show depths.

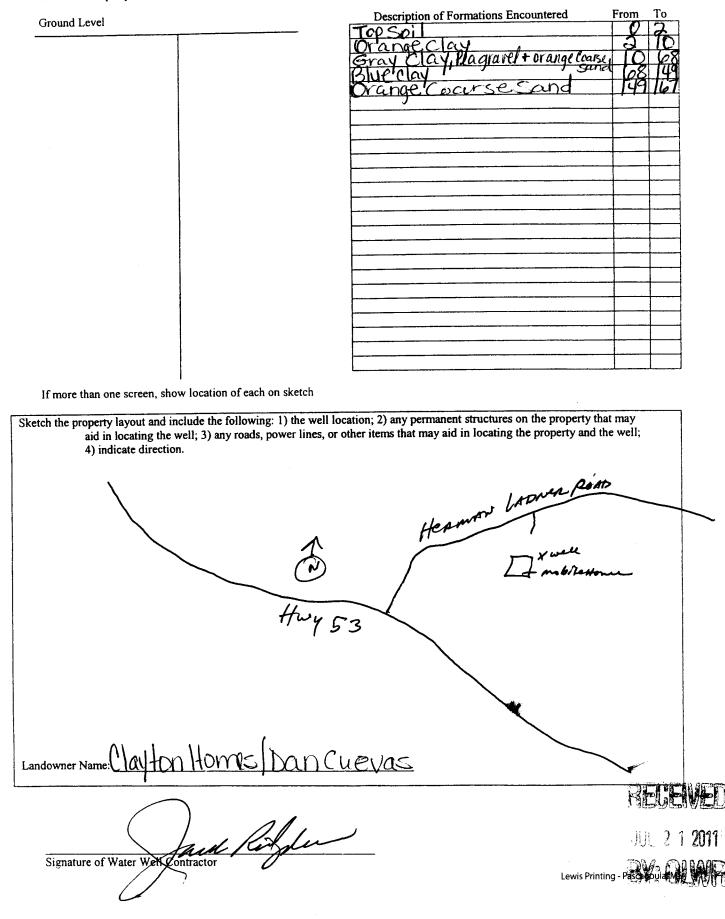

		STATE WI	ELL REPORT	STATE WELL REPORT				
county: Harriso	0	Pump Installer' Mississippi Departmen	art 2 s Completion Report at of Environmental Quality	For Office Use Only: Aquifer:				
Permit #: Driller (		Office of Land P.O. Jackson, M (601	and Water Resources Box 10631 MS 39289-0631 ) 961-5210 54-6938 (fax)	Well #: <u>A88</u> Elevation:				
•	d be prepared by t		and filed with the Departme	nt within 30 days of the				
W	ell Owner Informa	tion		Location 89				
Owner Name: Clayton Home/Dan Crevas				Longitude: 088 16' 34.56"				
Mailing Address: Hermanladner Rd.		Method of Lat/Long (circle one): Conventional Survey,						
				-held GPS) Survey-grade GPS				
S	ucier, Me	<u>39574</u> Zip Code		<u>1_Twn T5S Rng B13W</u>				
-	_			Distance Direction Nearest Town				
Telephone No.	831-8088	····	15 Miles Northon	<u>fassChristian</u>				
	Pump Type			ver Type				
	Circle one		Ci	rcle one				
Air Lift	Jet '	Submersible	Diesel Engine Gasolin	e Engine Natural Gas				
Bucket	Piston	Turbine (	Electric Motor Hand	Tractor PTO				
Centrifugal	Rotary	Flowing Well	Windmill Other (	specify):				
Other (specify):		Horse Power Rating of Motor:	2HP					
Date Pump Installed:		Setting Depth: <u>90FT. Dr</u>	oplipe_feet					
Rated Pump Capacity:		_Gallons Per Minute	Number of Stages: <u>3</u>					
	Pump Test Data			ssuring Water Level rcle one				
Date Well Tested:		Air Line Electric Meas						
Static Water Level (A):Feet Below Land Surface		Other (specify):						
Pumping Water Level (B): N A Feet Below Land Surface			<u>م)ارم</u>					
Drawdown [(B) – (A)]: N A Feet Below Land Surface		For flowing well, measured shu						
Test Pumping Rate:Gallons Per Minute		Well yielded 18	_GPM with a drawdown of					
Duration of Pump Test	(minimum 4 hours)	: hours	NA feet after	NAhours of pumping				
I HEREBY CERTIFY	that the above state	nents are true to the best o	f my knowledge.					
Jack Kic	ladell C	1-472		Splen				
Print Name of Pump Ir	staller and License	No. (if applicable)	Signature of Pump Ins	saller				
			V	నురికర్ <b>రా</b>				
				AUG 1 3 20				

- Stan	
--------	--