

HARRISON
A 2001
11-28-75

MISSISSIPPI
BOARD OF WATER COMMISSIONERS
416 North State Street
Jackson, Mississippi 39201

135

WATER WELL DRILLERS LOG

11-28-75 date well completed
McGill Well Works firm name
Harrison county well located

LANDOWNER: Fred Tanaka
Rt. 2, Box 182
Gulf, Miss.
(mailing address)

description of formations encountered	from to	
Red clay	0	26
Red shale	26	87
White pipe clay	87	168
Gravelly sand	168	210

WELL LOCATION:
sec. 34 T 5 N R 13 E
4 miles NW of ~~Thomson~~
(distance) (direction) (nearest town)

WELL PURPOSE: home
(home, irrigation, municipal, industrial)

WELL COMPLETION DATA:

(1) diameter (inches) 2"

(2) total depth (feet) 210'

(3) static water level (feet) 45' below top of ground

(4) casing 30' 40' 200'
(material) (depth)

(size) If telescope see back.

(5) screen 10' (length) (depth to top)
2" (size) plastic (material)


(6) pump 1 (HP) 4 (yield gpm)
Electric (type power)

(7) electric log NO (yes or no)

(organization running log)

(8) how well bottom plugged sand
spark

DRILLERS REMARKS:

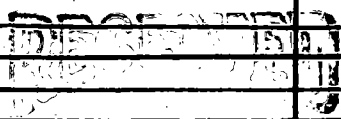

APR - 8 1976

If well telescopes please sketch and show depths.

GROUND LEVEL

X			

SECTION 34

Please indicate well location X.

ADDITIONAL INFORMATION

If more than one screen, show locations of each on sketch.