

HARRISON
A 2005
5/20/76

MISSISSIPPI
BOARD OF WATER COMMISSIONERS
416 North State Street
Jackson, Mississippi 39201
WATER WELL DRILLERS LOG

5-20-1976 date well completed
McNeil Well Drilling firm name
Harrison county well located

LANDOWNER: Clay Wedgewood
Rt. 2, Box 312
Pass Christian, MS.
(mailing/address)

description of formations encountered	depth	
	from	to
Clay	0	28
red sand	28	57
white clay	57	126
blue clay	126	331
concrete	331	357

WELL LOCATION:
sec. 31 T. 5 N R. 13 E
4 1/2 miles M.W. of Bayanna
(distance) (direction) (nearest town)

WELL PURPOSE: home
(home, irrigation, municipal, industrial)

WELL COMPLETION DATA:

(1) diameter (inches) 2"

(2) total depth (feet) 357'

(3) static water level (feet) 90' below top of ground.

(4) casing PVC Sch. 40 347'
(material) (depth)

(size) If telescope see back.

(5) screen 10' (length) (depth to top)
2" (size) plastic (material)

(6) pump 1 (HP) 5 (yield gpm)
electric (type power)

(7) electric log no (yes or no)

(organization running log)

(8) how well bottom plugged Sand Shale


DRILLERS REMARKS:

RECEIVED
JUL 11 1976

MISSISSIPPI BOARD OF WATER COMMISSIONERS

If well telescopes please sketch and show depths.

GROUND LEVEL

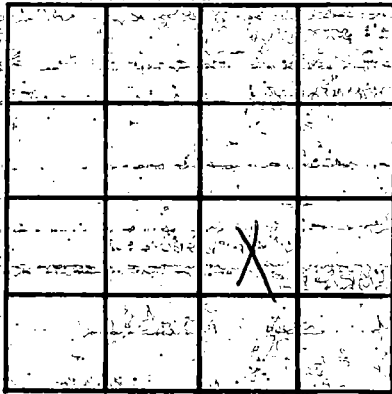

SECTION 31

Please indicate well location X.

ADDITIONAL INFORMATION

If more than one screen, show locations of each on sketch.