

HARRISON
A 2006
6/2/76

MISSISSIPPI
 BOARD OF WATER COMMISSIONERS
 416 North State Street
 135 Jackson, Mississippi 39201

WATER WELL DRILLERS LOG

6/2 1976 **COASTAL DRILLING & SERVICE CO. Harrison**
 date well completed ROUTE 1 BOX 618 county well located

LANDOWNER: **Boyd Arnold**
Northwood Villa Hermon
Mrs. Miss Smith-Job
 (mailing address)

Description of formations encountered	30532	
	from	to
Top Soil	1	3
Red Sand	3	20
Sandy Soil	20	45
Soft Blue Clay	45	150
Hard Shale	150	390
Loc. water sand	390	800
Comp. water sand	800	445

WELL LOCATION:
 sec 33 T 5 N R 13 E
 S W
 (4.7 miles New Sigma)
 (distance) (direction) (nearest town)

WELL PURPOSE: **Home**
 (home, irrigation, municipal, industrial)

- WELL COMPLETION DATA:
- (1) diameter (inches) 2"
 - (2) total depth (feet) 445'
 - (3) static water level (feet) 60 below top of ground.
 - (4) casing PVC 4 3/4"
 (material) (depth)
 If telescope see back.
 (size)
 - (5) screen 10' 4 3/4"
 (length) (depth to top)
 - (6) pump One 9
 (HP) (yield gpm)
Ele
 (type power)
 - (7) electric log no
 (yes or no)
 - (organization running log)


(8) how well bottom plugged
2" babbler hole

DRILLERS REMARKS:
none

RECEIVED
 JUN 29 1976
 MISS. Bd. OF WATER COMM.

If well telescopes please sketch and show depths.

GROUND LEVEL

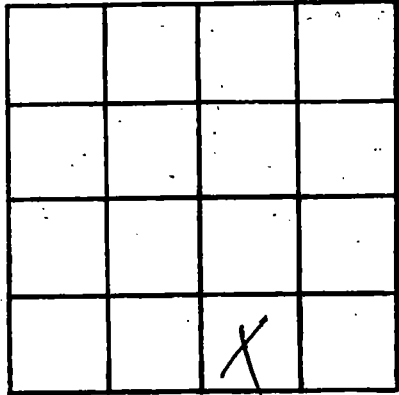

SECTION _____

Please indicate well location X.

ADDITIONAL INFORMATION

If more than one screen,
show locations of each on sketch.