

Need date Completed

~~Plan for 5712~~

HARRISON  
A 2007  
7/01/76

MISSISSIPPI  
BOARD OF WATER COMMISSIONERS  
416 North State Street  
Jackson, Mississippi 39201

WATER WELL DRILLERS LOG

19 J. B. Well Company Harrison  
date well completed firm name county well located

LANDOWNER: RAY PALCE  
RT 1 SAUCIER, MS  
35574  
(mailing address)

description of formations encountered	from	to
	0	
TOP SOIL & CLAY	5	10
SAND	10	20
SAND DEB GRAVEL	20	30
SAND DEB GRAVEL	30	40
SAND COURSE ROCKS	40	50
SAND DEB GRAVEL	50	53
CLAY RED	53	54
SAND -	54	60
SAND - COURSE	60	65
SAND COURSE	65	75

WELL LOCATION:  
sec 21 T S N R. 13 E  
on N 47 53 S W.  
(distance) miles (direction) of RICEVILLE  
(nearest town)

WELL PURPOSE:  
(home) irrigation, municipal, industrial

- WELL COMPLETION DATA:
- (1) diameter (Inches) 2
  - (2) total depth (feet) 75
  - (3) static water level (feet) 39 below above top of ground.
  - (4) casing PLASTIC, 70  
(material) (depth)  
(size) if telescope see back.
  - (5) screen 5 ft, 70'  
(length) (depth to top)  
2", PLASTIC  
(size) (material)
  - (6) pump 1 8-12  
(HP) (yield gpm)  
ELEC  
(type power)
  - (7) electric log NO  
(yes or no)  
NO  
(organization running log)
  - (8) how well bottom plugged BACK  
WASH KILNS

DRILLERS REMARKS: SET SET  
AT 64'


RECEIVED

JUL 13 1976

MISS. Bd. of WATER COMM

If well telescopes please sketch and show depths.

GROUND LEVEL

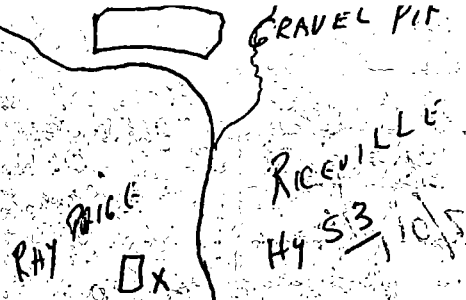


SECTION

Please indicate well location X.

ADDITIONAL INFORMATION

SAND IS BAD ABOUT  
 CAVING IN FROM 10 TO 40'  
 USED DRILLING MUD TO  
 HELP FORM)

If more than one screen, show locations of each on sketch.