

HARRISON
A 2008
9-25-76

MISSISSIPPI
 BOARD OF WATER COMMISSIONERS
 416 North State Street
 Jackson, Mississippi 39201
 WATER WELL DRILLERS LOG

9-25 ¹⁹⁷⁶ Duncan Well Drilling Harrison
 date well completed firm name county well located

| LANDOWNER: | description of formations encountered | from | to |
|---|---------------------------------------|------------|------------|
| <u>Roy D. Patton</u> | | | |
| <u>Rt 1 Box 232 Saucier, Miss</u> (mailing address) | <u>clay</u> | <u>0</u> | <u>42</u> |
| | <u>mud</u> | <u>42</u> | <u>105</u> |
| | <u>Blue clay</u> | <u>105</u> | <u>252</u> |
| | <u>Fine sand</u> | <u>252</u> | <u>294</u> |
| | <u>Course sand</u> | <u>294</u> | <u>315</u> |
| WELL LOCATION: sec <u>4</u> T <u>5</u> N R <u>13</u> E (S) W <u>7</u> miles <u>N</u> of <u>Lizena</u> (distance) (direction) (nearest town) | | | |
| WELL PURPOSE: <u>home</u> (home, irrigation, municipal, industrial) | | | |
| WELL COMPLETION DATA: (1) diameter (inches) <u>2"</u> (2) total depth (feet) <u>315'</u> (3) static water level (feet) <u>90'</u> ^{below} above top of ground. (4) casing <u>pvc</u> <u>305'</u> (material) (depth) _____ if telescope see back. (size) (5) screen <u>10'</u> <u>305'</u> (length) (depth to top) <u>2"</u> <u>stainless screen</u> (size) (material) (6) pump <u>1</u> <u>5</u> (HP) (yield gpm) <u>electric</u> (type power) (7) electric log <u>NO</u> (yes or no) _____ (organization running log) (8) how well bottom plugged <u>back</u> <u>Wash Valve</u> | | | |
| DRILLERS REMARKS: | | | |


RECEIVED

JAN 3 1977

MISS. BOARD OF WATER COMM

If well telescopes please sketch and show depths.

GROUND LEVEL

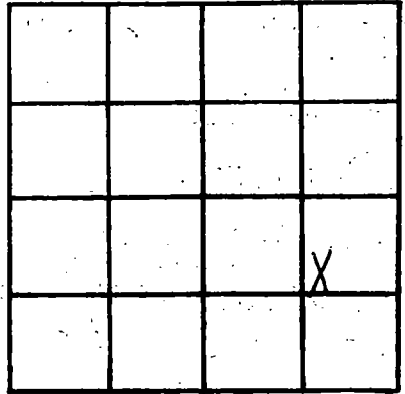

SECTION 4

Please indicate well location X.

ADDITIONAL INFORMATION

If more than one screen, show locations of each on sketch.