

HARRISON
A 2009
11/2/76

MISSISSIPPI
BOARD OF WATER COMMISSIONERS
416 North State Street
135 Jackson, Mississippi 39201

WATER WELL DRILLERS LOG

11-2 1976 Pernell Anderson Harrison
date well completed firm name county well located

| LANDOWNER: | description of formations encountered | from | to |
|-------------------|---------------------------------------|------|----|
| | | | |
| Dicky Joe Ladner | Top Soil | 0 | 4 |
| (mailing address) | Course Sand | 4 | 75 |

WELL LOCATION:
sec. 18 T 5 S R 13 E
6 miles NW of Lizaona
(distance) (direction) (nearest town)

WELL PURPOSE: HOME
(home, irrigation, municipal, industrial)

- WELL COMPLETION DATA:
- (1) diameter (inches) 2"
 - (2) total depth (feet) 75'
 - (3) static water level (feet) 26' below top of ground
 - (4) casing Plastic 40'
(material) (depth)
 - (size) If telescope see back.
 - (5) screen 5' 70'
(length) (depth to top)
 - 2" Plastic
(size) (material)
 - (6) pump 1 10
(HP) (yield gpm)
 - Elect
(type power)
 - (7) electric log no
(yes or no)
 - (organization running log)
 - (8) how well bottom plugged Clipped


DRILLERS REMARKS:

RECEIVED
DEC 1 1976

MISS. BD. OF WATER COMMISSIONERS

If well telescopes please sketch and show depths.

GROUND LEVEL

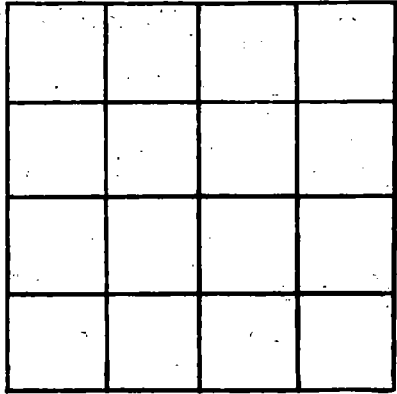

SECTION _____

Please indicate well location X.

ADDITIONAL INFORMATION

If more than one screen, show locations of each on sketch.