

HARRISON
A 2010
5-10-77

MISSISSIPPI
 BOARD OF WATER COMMISSIONERS
 416 North State Street
 Jackson, Mississippi 39201

WATER WELL DRILLERS LOG

MAY 10, 1977 1977 BRUANT Well Co. HARRISON
 date well completed firm name county well located

LANDOWNER: Stedley L. Adner
811-347m
Highway 53 STREET
Gulfport, MS 39501
 (mailing address)

WELL LOCATION:
 sec. 35 T 5 N R 13 E
3 miles NW of LIZ ANA
 (distance) (direction) (nearest town)

WELL PURPOSE: Home
 (home, irrigation, municipal, industrial)

WELL COMPLETION DATA:
 (1) diameter (inches) 4" x 2"
 (2) total depth (feet) 577
 (3) static water level (feet) 85 ^{below} _{above} top of ground.
 (4) casing PVC, 557,
 (material) (depth)
4" x 2" If telescope see back.
 (size) 20
 (5) screen 008, 577
 (length) (depth to top)
009, PVC
 (size) (material)
 (6) pump 1 1/2 20
 (HP) (yield gpm)
Sheet
 (type power)
 (7) electric log No
 (yes or no)
 (organization running log)

(8) how well bottom plugged Metal
SAW SHANK

description of formations encountered	from	to
clay	0	19
sand	19	35
clay	35	60
sand	60	70
clay	70	142
sand	142	160
clay	160	185
sand	185	200
clay	200	293
fine sand	293	300
clay	310	390
sand	390	497
clay	397	482
fine sand	482	488
clay	488	535
good sand	535	577


RECEIVED
 JUN 22 1977

MISS. Bd. Of WATER COMM

DRILLERS REMARKS:

If well telescopes please sketch and show depths.

GROUND LEVEL

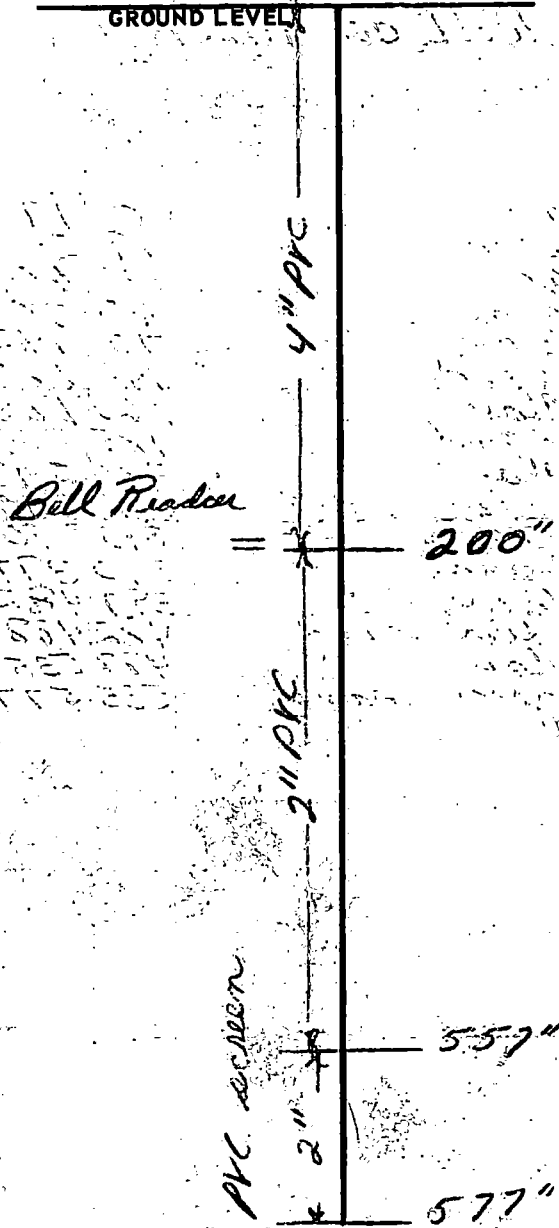

20	+	20	32

SECTION 35

Please indicate well location X.

ADDITIONAL INFORMATION

Handwritten notes and a signature in the 'ADDITIONAL INFORMATION' section. The signature appears to be 'D. J. ...'. There are also some faint handwritten notes, possibly '8x11'.

If more than one screen, show locations of each on sketch.