

HARRISON
A 2013
7-17-78

MISSISSIPPI
BOARD OF WATER COMMISSIONERS
416 North State Street
Jackson, Mississippi 39201

WATER WELL DRILLERS LOG

7/17/78 19 Coastal Drilling Harrison
date well completed firm name county well located
Biloxi Miss

LANDOWNER: Bailey Home
Allen Burtney
River Rd Suisun Miss
(mailing address)

description of formations encountered	from	to
top soil	1	3
Red Clay	3	20
Sugar Sand	20	45
Coarse white Sand	45	80
Sift Blue Clay	80	210
Hard Blue Clay	210	310
Permeable Sand	310	320
Consolidated Sand	320	365

WELL LOCATION:
sec. 11 T. 5 N R. 13 E
1/2 miles Biloxi miles of River
(distance) (direction) (nearest town)

WELL PURPOSE: home
(home, irrigation, municipal, industrial)

WELL COMPLETION DATA:
(1) diameter (inches) 2"
(2) total depth (feet) 365'
(3) static water level (feet) 40 below above top of ground.
(4) casing PVC 355'
(material) (depth)
(size) If telescope see back.
(5) screen 10' 355'
(length) (depth to top)
2" PVC
(size) (material)
(6) pump one 14
(HP) (field gpm)
ele
(type power)
(7) electric log no
(yes or no)
(organization running log)

(8) how well bottom plugged
2" backwash valve

DRILLERS REMARKS:


Miss. Board of Water Comm.

FEB 8 1979

RECEIVED

If well telescopes please sketch and show depths.

GROUND LEVEL

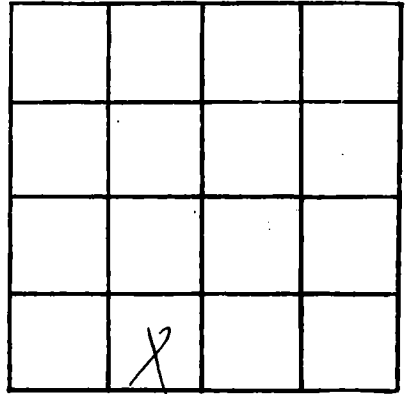

SECTION _____

Please indicate well location X.

ADDITIONAL INFORMATION

If more than one screen, show locations of each on sketch.