

**HARRISON**  
**A 2018**  
**8-10-80**

MISSISSIPPI  
 BOARD OF WATER COMMISSIONERS  
 416 North State Street  
 Jackson, Mississippi 39201

**WATER WELL DRILLERS LOG**

8/10/80 19 date well completed  
 Lyman Well Co. firm name  
 Harrison county well located

LANDOWNER: David Fazzo  
 Rt 1 Box 246  
 Saucier, MS 39574  
 (mailing address)

description of formations encountered	from	to
yellow clay	0	6
red clay & sand	6	18
grey clay	18	152
sand grey silt	152	177

WELL LOCATION:  
 sec. 10 T. 5 N. R. 13 E.  
 12 miles W of Saucier  
 (distance) (direction) (nearest town)

WELL PURPOSE: drinking  
 (home, irrigation, municipal, industrial)

WELL COMPLETION DATA:  
 (1) diameter (inches) 2  
 (2) total depth (feet) 177  
 (3) static water level (feet) 73 below/above top of ground  
 (4) casing PVC 167'  
 (material) (depth)  
2" If telescope see back.  
 (size)  
 (5) screen 10' 8167'  
 (length) (depth to top)  
6 slot PVC  
 (size) (material)  
 (6) pump 1 9  
 (HP) (yield gpm)  
electric  
 (type power)  
 (7) electric log no  
 (yes or no)

(organization running log)  
 (8) how well bottom plugged: Sand Shark

DRILLERS REMARKS:


DEPT. OF NATURAL RESOURCES  
 BUREAU OF LAND & WATER RESOURCES

NOV - 6 1980

**RECEIVED**

If well telescopes please sketch and show depths.

GROUND LEVEL

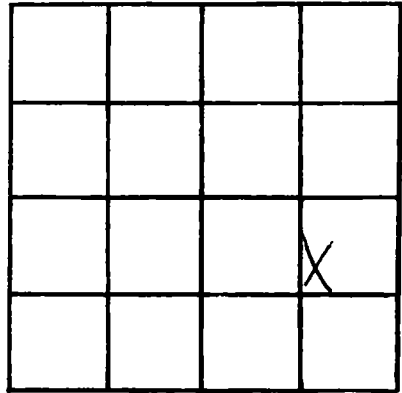

SECTION 10

Please indicate well location X.

ADDITIONAL INFORMATION

Lined area for additional information.

If more than one screen, show locations of each on sketch.