

Harrison  
A 2019  
7-12-80

MISSISSIPPI  
BOARD OF WATER COMMISSIONERS  
416 North State Street  
Jackson, Mississippi 39201

WATER WELL DRILLERS LOG

7/12/80 date well completed 19 Lipman Well Co. firm name Harrison county well located

LANDOWNER: A. Hickman  
Rt 2 Box 189 B  
Perkinston, Md 39573  
(mailing address)

description of formations encountered	from	to
yellow clay	0	7
Red sand & mud	7	28
grey clay blue clay	28	171
Band grey sand	171	184

WELL LOCATION:  
sec. 7 T 5 N R. 13 E  
10 miles NW of Lizana  
(distance) (direction) (nearest town)

WELL PURPOSE: Home  
(home, irrigation, municipal, industrial)

WELL COMPLETION DATA:  
(1) diameter (Inches) 2"  
(2) total depth (feet) 184'  
(3) static water level (feet) 112' below above top of ground.  
(4) casing PVC, 174',  
(material) (depth)  
2" If telescope see back.  
(size)  
(5) screen 10', 174'  
(length) (depth to top)  
6 slot PVC  
(size) (material)  
(6) pump 1 (HP) (yield-gpm)  
electric  
(type power)  
(7) electric log No  
(yes or no)


(organization running log)  
(8) how well bottom plugged Sand  
Shark

DRILLERS REMARKS:

DEPT. OF NATURAL RESOURCES  
BUREAU OF LAND & WATER RESOURCES  
NOV -6 1980  
**RECEIVED**

If well telescopes please sketch and show depths.

GROUND LEVEL

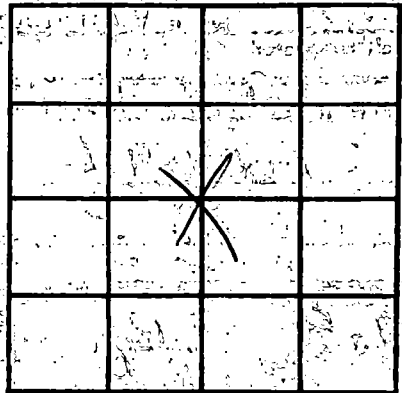

SECTION 7

Please indicate well location X.

ADDITIONAL INFORMATION

If more than one screen, show locations of each on sketch.