

MISSISSIPPI DEPARTMENT OF NATURAL RESOURCES

Bureau of Land and Water Resources

Southport Mall

P.O. Box 10631

Jackson, Mississippi 39209

WATER WELL DRILLERS LOG

HARRISON
A 2022
9-17-81

This is about 7 mi due west

9/17/81 19 Syman Well Co. Harrison
date well completed firm name county well located

LANDOWNERS: Bruce Fowle
Rt. 1, Box 80 B
Saucier, Md 39574
(mailing address)

description of formations encountered	from	to
Red Clay & Sand	0	36
Blue & grey Clay	36	160
good sand	160	194

WELL LOCATION:
sec. 10 T. 5 N. R. 13 E
15 miles N of Saucier
(distance) (direction) (nearest town)

WELL PURPOSE: Home
(home, irrigation, municipal, industrial)

WELL COMPLETION DATA:
(1) diameter (Inches) 2"
(2) total depth (feet) 194'
(3) static water level (feet) 43 below above
top of ground.
(4) casing PVC, 184'
(material) (depth)
2"
(size) if telescope see back.
(5) screen 10', 184'
(length) (depth to top)
2" PVC
(size) (material)
(6) pump 1 12
(HP) (yield gpm)
electric
(type power)
(7) electric log No
(yes or no)
No
(organization running log)

(8) how well bottom plugged sand
seal

DRILLERS REMARKS:


DEPT. OF NATURAL RESOURCES
BUREAU OF LAND & WATER RESOURCES

OCT 20 1981

RECEIVED

If well telescopes please sketch and show depths.

GROUND LEVEL

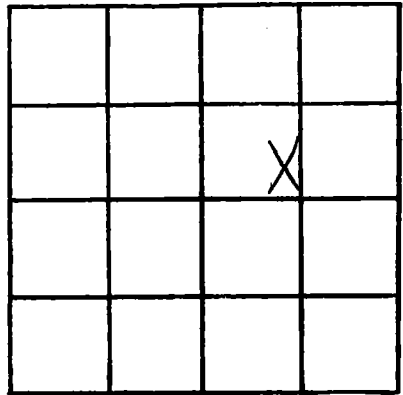

SECTION 10

Please Indicate well location X.

ADDITIONAL INFORMATION

If more than one screen, show locations of each on sketch.