

MISSISSIPPI DEPARTMENT OF NATURAL RESOURCES

Bureau of Land and Water Resources

Southport Mall

P.O. Box 10631

Jackson, Mississippi 39209

WATER WELL DRILLERS LOG

Hausir  
A  
2024

5/25 1982 Lyman Well Co. Harrison City  
 date well completed firm name county well located

LANDOWNER: Rodger Deroux  
Rt. 2, Box 418  
Perkinston, Miss 39513  
 (mailing address)

description of formations encountered	from	to
<u>White Sand</u>	<u>0</u>	<u>15</u>
<u>Red-White Clay</u>	<u>15</u>	<u>75</u>
<u>Good Sand</u>	<u>75</u>	<u>107</u>

WELL LOCATION:  
 sec 28 T 5 N R13 E W  
5 miles 10 of Fire Walk  
 (distance) (direction) (nearest town)

WELL PURPOSE: Home  
 (home, irrigation, municipal, industrial)

WELL COMPLETION DATA:

(1) diameter (inches) 2"

(2) total depth (feet) 107'

(3) static water level (feet) 60' below above top of ground.

(4) casing PVC 97'  
 (material) (depth)  
2"  
 (size) If telescope see back.

(5) screen 10' 107'  
 (length) (depth to top)  
2" PVC  
 (size) (material)

(6) pump 1 12  
 (HP) (yield gpm)  
Elec.  
 (type power)

(7) electric log NO  
 (yes or no)  
NO  
 (organization running log) Sand Shark

(8) how well bottom plugged Sand Shark

DRILLERS REMARKS:


DEPT. OF NATURAL RESOURCES  
 BUREAU OF LAND & WATER RESOURCES

JUL 14 1982

RECEIVED

If well telescopes please sketch and show depths.

GROUND LEVEL

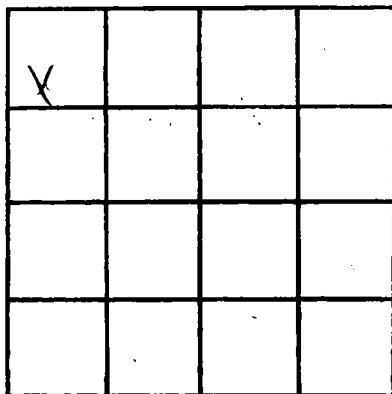

SECTION 28

Please indicate well location X.

ADDITIONAL INFORMATION

If more than one screen,  
show locations of each on sketch.