

MISSISSIPPI DEPARTMENT OF NATURAL RESOURCES
Bureau of Land and Water Resources
 Southport Mall
 P.O. Box 10631
 Jackson, Mississippi 39209
WATER WELL DRILLERS LOG

Harrison
A
2025

9/18/84 19 Ms. Neil Wolf Works Harrison
 date well completed firm name county well located

LANDOWNER: Y. M. Dearing
Table Bridge Rd.
P.O. Box 1111111
 (mailing address)

description of formations encountered	from	to
clay	0	60
sand	60	120
yellow sand	120	210
clay	210	270
yellow sand	270	340
clay	340	360
sand	360	480

WELL LOCATION:
 sec 21 T 5 N R B E
7 miles N of PC
 (distance) (direction) (nearest town)

WELL PURPOSE:
 (home, irrigation, municipal, industrial)

WELL COMPLETION DATA:

(1) diameter (inches) 4 1/2

(2) total depth (feet) 400

(3) static water level (feet) 60 below top of ground.

(4) casing 4 1/2" PVC (material) 380' (depth)
 If telescope see back.
 (size)

(5) screen 10' (length) 380' (depth to top)
2" mesh 40 mesh
 (size) (material)

(6) pump 1/2 (HP) 12 (yield gpm)
submersible
 (type power)

(7) electric log — (yes or no)
— (organization running log)

(8) how well bottom plugged well


DRILLERS REMARKS: —

DEPT. OF NATURAL RESOURCES
 BUREAU OF LAND & WATER RESOURCES

DEC - 3 1984
RECEIVED

If well telescopes please sketch and show depths.

GROUND LEVEL

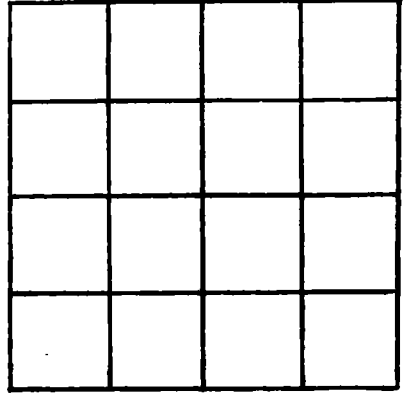

SECTION _____

Please indicate well location X.

ADDITIONAL INFORMATION

If more than one screen, show locations of each on sketch.