

MISSISSIPPI DEPARTMENT OF NATURAL RESOURCES
Bureau of Land and Water Resources
 Southport Mall
 P.O. Box 10631
 Jackson, Mississippi 39209
WATER WELL DRILLERS LOG

Harrison
A 2027

Dec. 22 1984 Braden Pump & Well Serv. Harrison
 date well completed firm name county well located

LANDOWNER: Donald Lee
Rt. 2, Bx 416
Perkinston, Ms 39573
 (mailing address)

description of formations encountered	from	to
	<u>Clay</u>	<u>0</u>
<u>Sand</u>	<u>60</u>	<u>120</u>
<u>Clay</u>	<u>120</u>	<u>123</u>

WELL LOCATION:
 sec. 2-T-5 R. 13
4 miles West of Riceville
 (distance) (direction) (nearest town)

WELL PURPOSE: Home
 (home, irrigation, municipal, industrial)

- WELL COMPLETION DATA:
- (1) diameter (inches) 2"
 - (2) total depth (feet) 123'
 - (3) static water level (feet) 55' below above top of ground.
 - (4) casing PVC, 103'
 (material) (depth)
2" if telescope see back.
 (size)
 - (5) screen 5', 103'
 (length) (depth to top)
2", PVC
 (size) (material)
 - (6) pump 1 8
 (HP) (yield gpm)
230 Volts
 (type power)
 - (7) electric log NO
 (yes or no)
 (organization running log)
 - (8) how well bottom plugged PVC Sand Shark


DRILLERS REMARKS:
15' tailpipe

DEPT. OF NATURAL RESOURCES
 BUREAU OF LAND & WATER RESOURCES

DEC 31 1984
RECEIVED

If well telescopes please sketch and show depths.

GROUND LEVEL

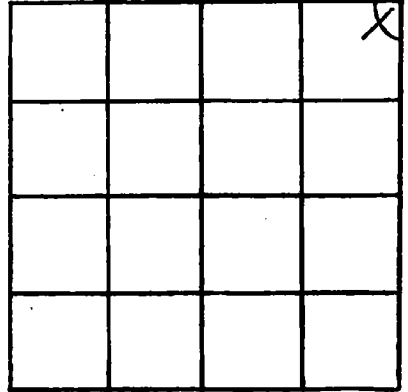

SECTION 7

Please indicate well location X.

ADDITIONAL INFORMATION

Lined area for additional information.

If more than one screen, show locations of each on sketch.