

MISSISSIPPI DEPARTMENT OF NATURAL RESOURCES

Bureau of Land and Water Resources

Southport Mall

P.O. Box 10631

Jackson, Mississippi 39209

WATER WELL DRILLERS LOG

| |
|----------|
| Harrison |
| A |
| 2030 |

3/4/85 19 Lyman Well Harrison
 date well completed firm name county well located

LANDOWNER: Mike Ladner
Rt. 1, Box 660
Pass Christian 39571
 (mailing address)

| description of formations encountered | from | to |
|--|------|-----|
| Blue clay <u>Blue clay</u> | 0 | 120 |
| <u>coarse sand</u> | 120 | 300 |
| | 300 | 334 |

WELL LOCATION:
 sec. 5 T. 5 N. R. 13 E.
3 miles D.W. of Dedens
 (distance) (direction) (nearest town)

WELL PURPOSE:
 (home, irrigation, municipal, industrial)

- WELL COMPLETION DATA:
- (1) diameter (inches) 2"
 - (2) total depth (feet) 344'
 - (3) static water level (feet) 120' ^{below} _{above} top of ground.
 - (4) casing PVC, 334'
 (material) (depth)
 - 2"
 (size) If telescope see back.
 - (5) screen 10', 334'
 (length) (depth to top)
 - 2", PVC
 (size) (material)
 - (6) pump N/A
 (MP) (yield gpm)
 - (type power)
 - (7) electric log No
 (yes or no)
 - No
 (organization running log)
 - (8) how well bottom plugged sand
shark


RECEIVED

APR 9 1986

DRILLERS REMARKS:

If well telescopes please sketch and show depths.

GROUND LEVEL

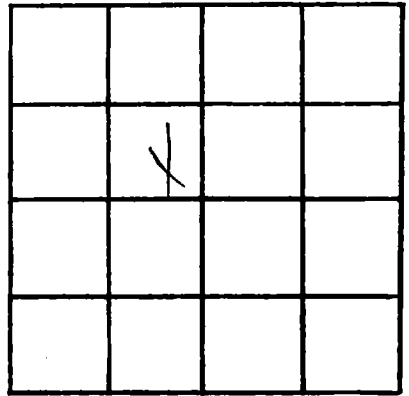

SECTION 6

Please indicate well location X.

ADDITIONAL INFORMATION

If more than one screen,
show locations of each on sketch.