

MISSISSIPPI DEPARTMENT OF NATURAL RESOURCES

Bureau of Land and Water Resources

Southport Mall

P.O. Box 10631

Jackson, Mississippi 39209

WATER WELL DRILLERS LOG

HARRISON
A
231

6/28/85 date well completed Lyman Well Co. firm name Harrison county well located

LANDOWNER: Matthew A. Philpott
 Pt. 8, 712 Beverly Dr.
 Gulfport, MS 39503 (mailing address)

Description of formations encountered	from	to
White clay	0	40
Red sand gravel	40	125

WELL LOCATION:

sec. 6 T-5 N R-13 E
 S W
 5 miles South of Li Jang
 (distance) (direction) (nearest town)

WELL PURPOSE: House
 (home, irrigation, municipal, industrial)

WELL COMPLETION DATA:

(1) diameter (inches) 2"
 (2) total depth (feet) 105'
 (3) static water level (feet) 40' below top of ground.

(4) casing PVC, 95'
 (material) (depth)
2" If telescope see back.
 (size)

(5) screen 10', 95'
 (length) (depth to top)
2", PVC
 (size) (material)

(6) pump N/A
 (HP) (yield gpm)
 (type power)

(7) electric log No
 (yes or no)
No
 (organization running log)

(8) how well bottom plugged sand
Shark


DRILLERS REMARKS:

RECEIVED
 APR 2 1986

Department of Natural Resources
 Bureau of Land & Water Resources

If well telescopes please sketch and show depths.

GROUND LEVEL

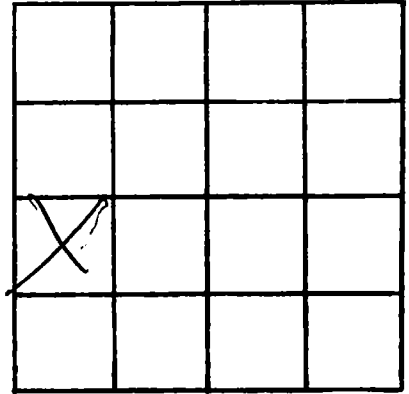

SECTION 6

Please indicate well location X.

ADDITIONAL INFORMATION

If more than one screen,
show locations of each on sketch.