

HARRISON
A 2-33

Bureau of Land and Water Resources
Southport Mall
P.O. Box 10631
Jackson, Mississippi 39209
WATER WELL DRILLERS LOG

2-18-86 19 Broden Pump & Well Service, Inc. Harrison
date well completed firm name county well located

LANDOWNER: Laurellia Lodner
Rt. 1 Box 232
Saucier, Miss. 39574
(mailing address)

| description of formations encountered | from | to |
|---------------------------------------|------|-----|
| Surface | 0 | 6 |
| Red Clay | 6 | 16 |
| White Sand | 16 | 36 |
| White Clay | 36 | 50 |
| Brown Sand | 50 | 80 |
| Blue clay | 80 | 82+ |


WELL LOCATION:
sec. 35 T. 5 S. R. 13 E.
1 1/2 miles NW of Lizana
(distance) (direction) (nearest town)

WELL PURPOSE: Home
(home, irrigation, municipal, industrial)

WELL COMPLETION DATA:

- (1) diameter (inches) 2"
- (2) total depth (feet) 82
- (3) static water level (feet) 40 below top of ground.
- (4) casing PVC, 20
(material) (depth)
2" (size) if telescope see back.
- (5) screen 10, 20
(length) (depth to top)
2" (size), PVC (material)
- (6) pump 1, 10
(HP) (yield gpm)
220V 1/2 (type power)
- (7) electric log NO
(yes or no)
(organization running log)
- (8) how well bottom plugged
PVC Sand Shod

DRILLERS REMARKS:

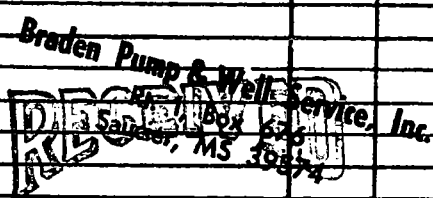

Department of Natural Resources
Bureau of Land & Water Resources

