

MISSISSIPPI DEPARTMENT OF ENVIRONMENTAL QUALITY

QUALITY

Office of Land and Water Resources

P. O. Box 10631

Jackson, MS 39289-0631

WATER WELL DRILLERS LOG

COUNTY WELL LOCATED Harrison	
WELL NUMBER A-2046	CODED
DATE WELL COMPLETED 6-21-00	

PERMIT NUMBER 0404
NAME OF DRILLING FIRM Lyman Well Company
Gulfport, Ms 39503

NAME & MAILING ADDRESS OF LANDOWNER Dan McMuldren	
20181 Old Hwy 49	
Saucier, Ms 39574	
WELL LOCATION	SEC 34 TOWNSHIP 5 RANGE N 13 E
DISTANCE _____ Miles _____ of _____	
DIRECTION _____ NEAREST TOWN _____	
OTHER LANDMARK _____	
WELL PURPOSE <u>Home</u> , Irrigation, Municipal, Industrial, Fish Pond, etc.	

PUMP DATA		
PUMP TYPE (Circle One): <u>Submersible</u> Turbine, Jet, Flowing Well, Other (Describe) _____		
POWER TYPE (Circle One): <u>Electric</u> Tractor, Diesel, Gasoline, Butane, Other (Describe) _____ H/P <u>1 1/2</u>		
Pump Capacity (GPM) 19	No. of Stages 12	Setting Depth 180 FT.
PUMP TEST		
Well yielded _____ GPM with a drawdown of _____ ft. after _____ hours of pumping		

WELL DATA		
Well Depth 580'	Casing Diameter (In) 4" x 2"	Casing Length (Ft) 560'
Type of Casing PVC	Hole Depth 583	Depth to Static Water Level 151'

LOG DATA	
TYPE OF LOG RUN (Circle One): <u>No Log Run</u> , Electric, Gamma Ray, Density, Sonic, Neutron, Other (Describe) _____	
Name of Organization Running Log _____	

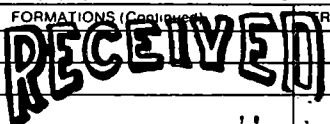
TYPE OF COMPLETION: (Circle One or More): <u>Gravel Packed</u> , Underreamed, Telescoped, <u>Natural Development</u> , Open Hole, Other (Describe) _____	
WELL GROUTED TO A DEPTH OF <u>26</u> FEET Type Grout (circle one): Cement, Bentonite, or Mix _____	

GEOLOGIC DATA (Office Use Only)			
Surface Elev.	Geologic Unit	Unit Thickness	Depth to Top
Subs. SWL	Date	Analysis	Aquifer Test

SCREEN DATA		
Diameter - Inches 2"	Length - Feet 20'	Slot Size - Inches .008
Screen Type PVC	Depth to Bottom - Feet	

Driller's Remarks	
Top of Lap Pipe or Reduction in Casing	
FEET	IF TELESCOPED OR MORE THAN ONE SCREEN: USE BACK PAGE

DESCRIPTION OF FORMATIONS ENCOUNTERED	FROM	TO

FORMATIONS (Continued)	FROM	TO
 JUL 26 2000 Dept. of Environmental Quality Office of Land & Water Resources		
IF MORE SPACE IS NEEDED, USE BACK		

If well telescopes please
sketch and show depths.

GROUND LEVEL

SECTION _____

Please indicate well location X.

ADDITIONAL INFORMATION

RECEIVED

JUL 8 1968

Office of Land & Water Resources
Dept. of Environmental Quality

If more than one screen,
show location of each on sketch.