

MISSISSIPPI DEPARTMENT OF ENVIRONMENTAL QUALITY

Office of Land and Water Resources

P. O. Box 10631
Jackson, MS 39289-0631

WATER WELL DRILLERS LOG

COUNTY WELL LOCATED Harrison	
WELL NUMBER A-2078	CODED
DATE WELL COMPLETED 9-20-01	

PERMIT NUMBER
NAME OF DRILLING FIRM Nacaise Well Service
Gulfport, MS

NAME & MAILING ADDRESS OF LANDOWNER Dwayne Spell			
Lot 63, Flushing Meadows, Snucier			
Latitude: Longitude:			
WELL LOCATION	SEC 24	TOWNSHIP 5	RANGE N 13 E
DISTANCE 4 Miles	DIRECTION N	NEAREST TOWN LIZANA	
OTHER LANDMARK			
WELL PURPOSE: <u>Home</u> , Irrigation, Municipal, Industrial, Fish Pond, etc.			

PUMP DATA			
PUMP TYPE (Circle One): Submersible, Turbine, Jet, Flowing Well, Other (Describe) _____			
POWER TYPE (Circle One): Electric, Tractor, Diesel, Gasoline, Butane, Other (Describe) _____ H/P _____			

DESCRIPTION OF FORMATIONS ENCOUNTERED	FROM	TO
CLAY	0	15
SAND	15	60
G. SAND	60	70
CLAY	70	90
SAND	90	110

WELL DATA

Well Depth 110	Casing Diameter (In.) 2	Casing Length (Ft.) 100
Type of Casing PVC	Hole Depth 110	Depth to Static Water Level 30
TYPE OF COMPLETION: (Circle One or More): Gravel Packed, Underreamed, Telescoped, Natural Development, Open Hole, Other (Describe) _____		
WELL GROUTED TO A DEPTH OF 10 FEET Type Grout (circle one): Cement, Bentonite, or Mix		

SCREEN DATA

Diameter - Inches 2	Length - Feet 10	Slot Size - Inches .006
Screen Type PVC	Depth to Bottom - Feet 110	

RECEIVED

JUL 11 2002

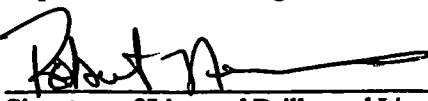
BY: OLWR

Top of Lap Pipe or Reduction in Casing

FEET

IF TELESCOPED OR MORE THAN ONE SCREEN: USE BACK PAGE

I certify that the well was drilled, constructed and completed in accordance with all applicable Requirements of the Mississippi Department of Environmental Quality and/or the Mississippi Department of Health regulations and state laws.


Signature of Licensed Driller and License No. **0-6660**

09-20-01
Date

Additional Information Required On Back

If well telescopes please sketch and show depths.

GROUND LEVEL

SECTION _____

Please indicate well location X.

Pump Capacity (GPM)	No. of Stages	Setting Depth	FT.
---------------------	---------------	---------------	-----

PUMP TEST

Well yielded _____ GPM with
 a drawdown of _____ ft.
 after _____ hours of pumping

LOG DATA

TYPE OF LOG RUN (Circle One): No Log Run
 Electric, Gamma Ray, Density, Sonic, Neutron,
 Other (Describe) _____

Name of Organization Running Log

GEOLOGIC DATA (Office Use Only)

Surface Elev.	Geologic Unit	Unit Thickness	Depth to Top
Subs. SWL	Date	Analysis	Aquifer Test

Driller's Remarks

Well Only

If more than one screen,
 show location of each on sketch.