

B-13

2-20-63

WATER WELL DRILLERS LOG

CODED

Date: 2-20, 1963, Driller: J. Beall County Harrison

(Name)

(1) Owner of Land: Simon Holland

(Name)

Rt 1. Box 117, Sardin

(Address)

(2) Location: NW 1/4, NW 1/4, Sec 29 N 12 R 12

5 miles East of Lyons

(distance)

(direction)

(Nearest Town)

(3) Topography: X (Hilly) (Flat) (Level)

(4) Purpose of Well: Home (Domestic Irrigation, Municipal, Industrial, Other)

Description & Color of Materials Sand, Clay, Red Clay, Shell, etc.	Thick- ness Feet	Depth Feet
Red Clay & sand	90	90
white soft mud	60	150
Hard Blue mud	55	205
water strata	19	224

Information upon completion of well:

(1) Diameter 2 1/4 inches.

(2) Total Depth 224 feet.

(3) Water Level _____ feet below top of ground.

(4) Cased to _____, Size _____.

(5) Screen: Size _____, Length _____.


(6) Were any formations sealed against pollution? _____ yes, _____ no.

If YES depth of formation _____.

Why _____.

Drillers Remarks: _____.

CODED

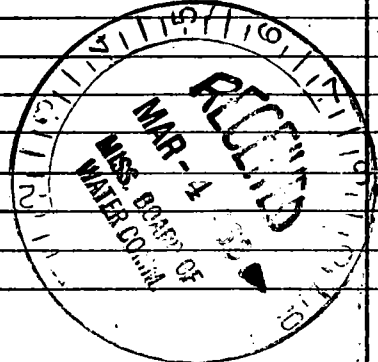

(Use Back Side)

Well No.

