

B 15

2-23-65 WATER WELL DRILLERS LOG

Date: Feb 23, 1965, Driller: Joe Miller County: Harrison
 (Name)

(1) Owner of Land: Doc Carter
 (Name)
Hawson Miss
 (Address)

(2) Location: 1/4, 1/4, Sec. T. R.
 miles of
 (distance) (direction) (Nearest Town)

(3) Topography: Hilly
 (Hilly) (Flat) (Level)

(4) Purpose of Well: Domestic
 (Domestic Irrigation
 Municipal, Industrial, Other)

Description & Color of Materials Sand, Clay, Red Clay, Shell, etc.	Thick- ness Feet	Depth Feet
Surface	5	5
Red Clay	30	35
Red Sand white	45	80
Blk Clay	22	102
Blue Clay	78	180
Silt	10	190
Light. Sand	11	201
" " Fine	10	211
" " "	10	221
" " "	11	232
" " Sand	10	242
" " "	10	252
" " "	3	255
" " Fine	14	259

Information upon completion of well:

(1) Diameter 2" inches.

(2) Total Depth 259 feet.


(3) Water Level 94' feet below top of ground.

(4) Cased to 245, Size 2"

(5) Screen: Size 2", Length 10'

(6) Were any formations sealed against pollution?
 yes, no.

Stall Sand

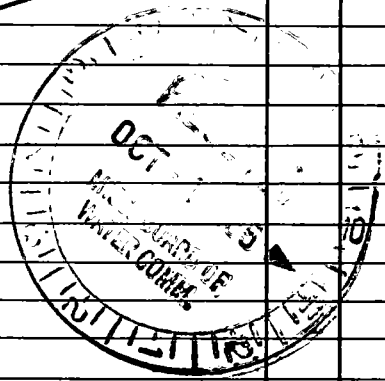

If YES depth of formation
 Why

Drillers Remarks:

(Use Back Side)

Well No.

S

HKy 49

old HKy.

Doc Carter's

W

Houison
MISS

unintelligible

N

E

