

HAR.
B 14
1-64

MISSISSIPPI BOARD OF WATER COMMISSIONERS

WATER WELL DRILLERS LOG

Date: Jan, 1964, Driller: Joe Miller County Harrison
(Name)

(1) Owner of Land: Charles Wilson
(Name)
Sumner Miss
(Address)

(2) Location: 1/4, 1/4, Sec. T R R
1 miles S.W., of Sumner
(distance) (direction) (Nearest Town)

(3) Topography: Hilly
(Hilly) (Flat) (Level)

(4) Purpose of Well: Domestic
(Domestic Irrigation
Municipal, Industrial, Other)

Description & Color of Materials Sand, Clay, Red Clay, Shell, etc.	Thick- ness Feet	Depth Feet
<u>Red & Brown Clay</u>	<u>35</u>	<u>35</u>
<u>Fine Brown Sand</u>	<u>5</u>	<u>40</u>
<u>Blue Clay</u>	<u>54</u>	<u>94</u>
<u>Fine Sand & Clay</u>	<u>22</u>	<u>116</u>
<u>Blue Clay</u>	<u>76</u>	<u>192</u>
<u>Fine Blue Sand</u>	<u>8</u>	<u>200</u>
<u>" " " "</u>	<u>10</u>	<u>210</u>
<u>Fine " " " "</u>	<u>11</u>	<u>221</u>
<u>" " " "</u>	<u>5</u>	<u>226</u>
<u>Broken Sand & Clay</u>	<u>90</u>	<u>236</u>


Information upon completion of well:

- (1) Diameter 2" inches.
- (2) Total Depth 226 feet.
- (3) Water Level 3.8 feet below top of ground.
- (4) Cased to 216, Size 2"
- (5) Screen: Size 2", Length 10'
- (6) Were any formations sealed against pollution?
no

If YES depth of formation _____

Why _____

Drillers Remarks: _____

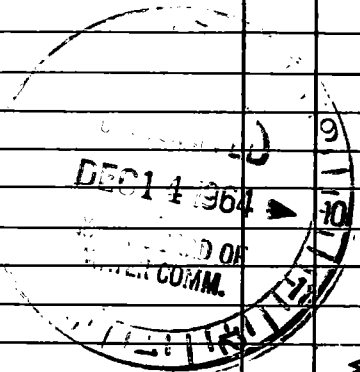

Well No. _____

(Use Back Side)



old Hky d9

Wilson



Hky 49

Saucier