

B 19 MS14608

8-28-65

WATER WELL DRILLERS LOG

**CODED**

Date: Aug 28, 1965, Driller: Joe Miller County: Harrison  
 (Name)

(1) Owner of Land: Mr Rodcher  
 (Name)  
R.D.H. Sauer Miss  
 (Address)  
NN 1/4 NN  
 (2) Location: 1/4, 1/4, Sec. 23 T5 R12  
5 miles Southeast of Sauer  
 (distance) (direction) (Nearest Town)  
 (3) Topography: Hilly  
 (Hilly) (Flat) (Level)  
 (4) Purpose of Well: Domestic  
 (Domestic Irrigation, Municipal, Industrial, Other)

Description & Color of Materials Sand, Clay, Red Clay, Shell, etc.	Thick- ness Feet	Depth Feet
Surface Sand	7	7
White Clay	3	10
Wh Sand	3	13
Blue Clay	91	104
Gray Sand (fine)	16	120
Fine Blue Clay	70	190
Gray Sand. Fine	10	200
" " "	21	221
" " Hard.	34	255
Still Sand		

Information upon completion of well:


(1) Diameter 2 inches.  
 (2) Total Depth 255 feet.  
 (3) Water Level 7p ground feet below top of ground.  
 (4) Cased to 240, Size 2"  
 (5) Screen: Size 2", Length 10'  
 (6) Were any formations sealed against pollution?  
 \_\_\_\_\_ yes, \_\_\_\_\_ no.

If YES depth of formation \_\_\_\_\_  
 Why \_\_\_\_\_

Drillers Remarks: \_\_\_\_\_

5' Just Lake.

**CODED**

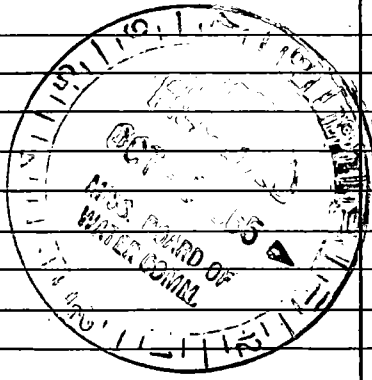

Well No.

(Use Back Side)

HKy 49

1319 Biloxi  
River

Rodacker

Old HKy

Yankee  
Rd

1520 CIPY  
MISS

