

HAR.

MISSISSIPPI BOARD OF WATER COMMISSIONERS

B20

M513502

CODED

10-10-64

WATER WELL DRILLERS LOG

Date: Oct 10, 1964, Driller: Joe Miller County Harrison


(1) Owner of Land: Pepe Herrin (Name), Saucier Miss (Address)
(2) Location: 1/4, 1/4, Sec 12, 5, 12, West of Saucier (Nearest Town)
(3) Topography: Hilly (Hilly) (Flat) (Level)
(4) Purpose of Well: Domestic (Domestic Irrigation, Municipal, Industrial, Other)

Table with 3 columns: Description & Color of Materials, Thickness Foot, Depth Foot. Includes entries like Surface, Top Gravel, Red Sand, Brown Clay, etc.

Information upon completion of well:

(1) Diameter 2 inches.
(2) Total Depth 395 feet.
(3) Water Level 112 feet below top of ground.
(4) Cased to 385, Size 2
(5) Screen: Size 2, Length 10
(6) Were any formations sealed against pollution? yes, no.

CODED

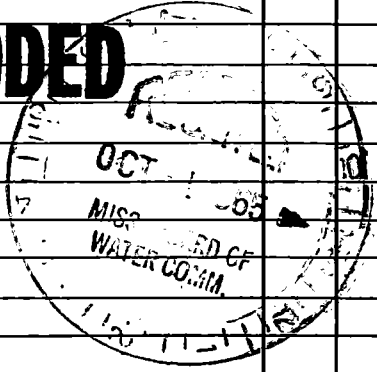

If YES depth of formation
Why
Drillers Remarks:

(Use Back Side)


Well No.

0300

N.

4

ke

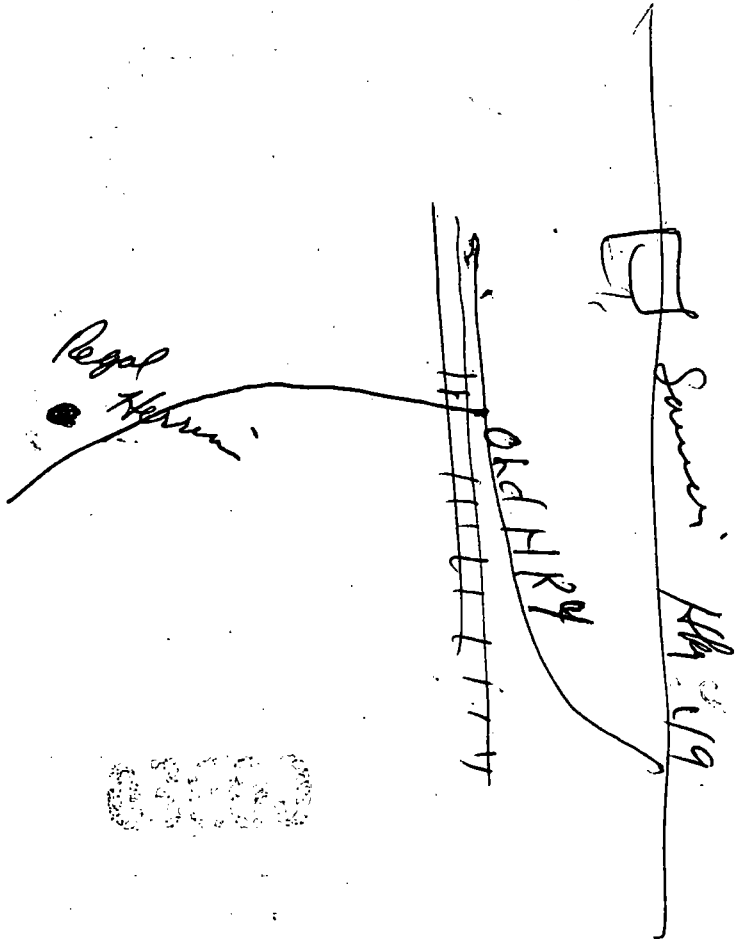

0300

III

S. III