

B 21  
3-66

WATER WELL DRILLERS LOG

**CODED**

Date: Apr 26, 1966, Driller: Joe Miller County Harrison  
(Name)

(1) Owner of Land: Curtis Sauer  
(Name)  
RR # Sauer  
(Address)

(2) Location: 5 12 1/4, 1/4, Sec. 11 T3 R4W  
3 miles West, of Sauer  
(distance) (direction) (Nearest Town)

(3) Topography: Hilly  
(Hilly) (Flat) (Level)

(4) Purpose of Well: Domestic  
(Domestic Irrigation  
Municipal, Industrial, Other)

Description & Color of Materials Sand, Clay, Red Clay, Shell, etc.	Thick- ness Feet	Depth Feet
Surface	5	5
Wh. Cl. & Rd. Cl.	30	35
Blue Clay	61	196
Fine Sand	5	201
Imp. Break + Clay	10	211
Hummy Clay	11	221
Hard Blue Clay	19	240
Grey Sand Fin.	13	253
" " Lead	7	260
" " Small Gravel	20	280
" " Little Finer	6	286

Information upon completion of well:


- (1) Diameter 2 inches.
- (2) Total Depth 286 feet.
- (3) Water Level 42' feet below top of ground.
- (4) Cased to 271, Size 2"
- (5) Screen: Size 2", Length 10'
- (6) Were any formations sealed against pollution?  
\_\_\_\_\_ yes, \_\_\_\_\_ no.

If YES depth of formation \_\_\_\_\_

Why \_\_\_\_\_

Drillers Remarks: \_\_\_\_\_

**CODED**

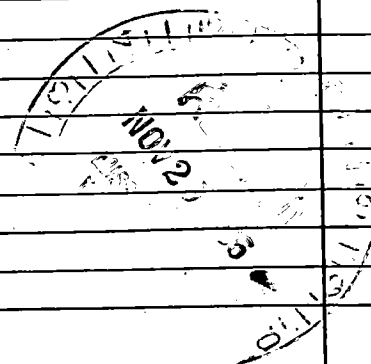

(Use Back Side)

Well No.

SECTION

N

W

Lower Well

Summer

OLD HRy 49

E

Bay Below

S

