

HAR. MISSISSIPPI BOARD OF WATER COMMISSIONERS

B 22

10-30-66 WATER WELL DRILLERS LOG

Date: Oct 30, 1966, Driller: Joe Miller County Lewis
(Name)

(1) Owner of Land: Pole Plant
(Name)
Howison Miss
(Address)

(2) Location: 1/4, 1/4, Sec. T R R
1 miles of Howison
(distance) (direction) (Nearest Town)

(3) Topography: Hilly
(Hilly) (Flat) (Level)

(4) Purpose of Well: Drinking Toilet
(Domestic Irrigation
Municipal, Industrial, Other)

Description & Color of Materials Sand, Clay, Red Clay, Shell, etc.	Thick- ness Feet	Depth Feet
Surface Hard Clay	7	7
Red Sand	55	62
White Clay		72
Hard Blue Clay	10	173
Sand Fair Blue Gr	6	179
" Good "	21	190
" " "	11	201
" Real Good "	10	211
" " "	16	227

Information upon completion of well:

(1) Diameter 2" inches.

(2) Total Depth 227' feet.


(3) Water Level 76' feet below top of ground.

(4) Cased to 222', Size 2"

(5) Screen: Size 2", Length 10'

(6) Were any formations sealed against pollution?
 yes, no.

*Still Sand,
3" Jail Pipe,*

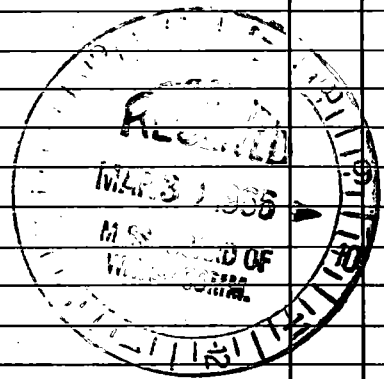

If YES depth of formation _____

Why _____

Drillers Remarks: _____

(Use Back Side)

Well No.

Handwritten notes at the top left, possibly including a date or page number.

Main body of handwritten text on the left side, appearing to be a list or series of entries.

Handwritten notes at the top right, possibly including a date or page number.

Handwritten notes in the middle right section, possibly including a date or page number.

Main body of handwritten text on the right side, appearing to be a list or series of entries.

Handwritten notes at the bottom right, possibly including a date or page number.