


Harrison
B 24
6-67

MISSISSIPPI
BOARD OF WATER COMMISSIONERS
416 North State Street
Jackson, Mississippi 39201

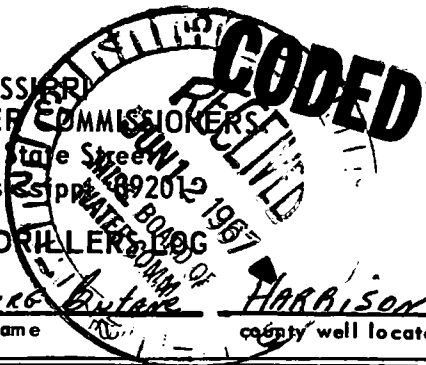

WATER WELL DRILLER LOG

6-8 1967 Hattiesburg Butere HARRISON
date well completed firm name county well located

LANDOWNER: H-W. Weaver

Rt. 1 Box 126-A

Javeier, Miss.
(mailing address)

WELL LOCATION:

sec. 34 T 5 S R 12 W

_____ miles _____ of _____
(distance) (direction) (nearest town)

WELL PURPOSE: Home
(home, irrigation, municipal, industrial)

WELL COMPLETION DATA:

(1) diameter (inches) 2"

(2) total depth (feet) 189'

(3) static water level (feet) 42' below above top of ground.

(4) casing GALV. pipe 179'
(material) (depth)

2" if telescope see back.
(size)

(5) screen 10' 179'
(length) (depth to top)

2" BRONZE
(size) (material)

(6) pump 1 325
(HP) (yield gpm)

electric
(type power)

(7) electric log NO
(yes or no)

NO
(organization running log)

(8) how well bottom plugged BACK WASH VALVE

description of formations encountered	from	to
yellow clay	0	9
yellow sand	10	14
white clay	15	19
gray clay	20	24
white clay	25	49
Blue clay	50	68
Blue sand	69	75
Blue clay	76	115
Blue sand	116	189



DRILLERS REMARKS:

If well telescopes please sketch and show depths.

GROUND LEVEL

		34	X

SECTION 34

Please indicate well location X.

ADDITIONAL INFORMATION

Keep old Hwy #9 past
 Robinwood Guernsey Farm;
 Turn onto Hartman Road
 2nd house on left.

If more than one screen, show locations of each on sketch.