

Harrison
 B25
 8-67

MISSISSIPPI
 BOARD OF WATER COMMISSIONERS
 416 North State Street
 Jackson, Mississippi 39201

CODED

WATER WELL DRILLERS LOG

8-29 1967 HATTIESBURG BUTANE HARRISON
 date well completed firm name county well located

LANDOWNER: MRS. LUTHER CURRIE
536 Pennsylvania Ave.
Jackson, Miss.
 (mailing address)


WELL LOCATION:
 sec. 1 T. 5 S. R. 12 W.
0 miles West-side of Saucier
 (distance) (direction) (nearest town)

WELL PURPOSE: Home
 (home, irrigation, municipal, industrial)

- WELL COMPLETION DATA:
- diameter (inches) 2"
 - total depth (feet) 155'
 - static water level (feet) 75 below above top of ground.
 - casing Galv. pipe 145' (material) (depth)
2" (size) If telescope see back.
 - screen 10' (length) 145' (depth to top)
2" (size) BRONZE (material)
 - pump 1 (HP) 375 (yield gpm)
Electric (type power)
 - electric log NO (yes or no)
NO (organization running log)
 - how well bottom plugged BACK WASH VALVE

description of formations encountered	from	to
Red clay	0	18
White sand	19	28
Red clay	29	55
Red sand	56	78
Red clay	79	85
Blue clay	86	118
Blue sand	119	150
Blue clay	151	155

CODED

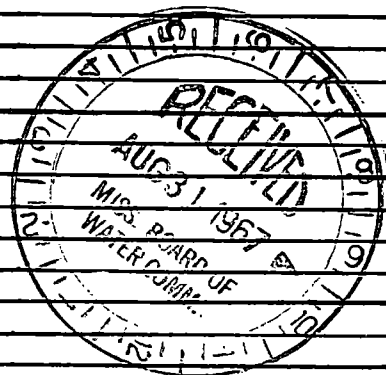

DRILLERS REMARKS:

If well telescopes please sketch and show depths.

GROUND LEVEL

			X

SECTION 1

Please indicate well location X.

ADDITIONAL INFORMATION

*Clyde Schwens lives on
property. Rents from
Mrs. J. Currier.*

If more than one screen,
show locations of each on sketch.