

Wortham, Ed.  
 Harrison  
 B 26  
 - 8-67

MISSISSIPPI  
 BOARD OF WATER COMMISSIONERS  
 416 North State Street  
 Jackson, Mississippi 39201


**CODED**

WATER WELL DRILLERS LOG

8-29 1967 date well completed  
 Switzer Well Co. firm name  
 Harrison county well located

LANDOWNER: Francis Fairley	description of formations encountered	from	to
Route 1 Box 431	clay	0	22
Spucier, Miss.	clay + sand strks	22	43
(mailing address)	clay	43	63
	clay + sand strks	63	105
WELL LOCATION:	clay	105	115
sec 35 T 5 S R 12 E	fine sand	115	124
2 1/2 miles W of WORTHAM	good sand	124	145
(distance) (direction) (nearest town)	good	145	147
WELL PURPOSE: Home	clay	147	227
(home, irrigation, municipal, industrial)	clay + sand strks	227	248
WELL COMPLETION DATA:	mixed	248	269
(1) diameter (inches) 2	fine sand	269	310
(2) total depth (feet) 346	good sand	310	349
(3) static water level (feet) 42 below top of ground			
(4) casing gal. steel 3 3/8" (material) 346' (depth)			
2" (size) If telescope see back.			
(5) screen 10' (length) 3 3/8" (depth to top)			
8 ga. SS on pipe (size) (material)			
(6) pump not installed (HP) (yield gpm)			
(type power)			
(7) electric log No (yes or no)			
(organization running log)			
(8) how well bottom plugged Back pressure valve			
DRILLERS REMARKS:			

**CODED**

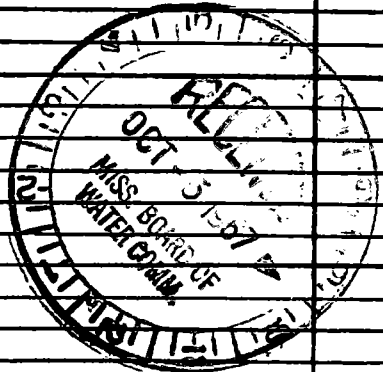

If well telescopes please sketch and show depths.

GROUND LEVEL

	X		

SECTION 35

Please indicate well location X.

ADDITIONAL INFORMATION

If more than one screen, show locations of each on sketch.