

HARRISON
B 28
2-68

MISSISSIPPI
BOARD OF WATER COMMISSIONERS
416 North State Street
Jackson, Mississippi 39201

CODED

WATER WELL DRILLERS LOG

3-12-1968 date well completed
Sutter Well Works firm name
Harrison county well located

LANDOWNER: DR. E.N. SAUCIER
415 E. Beach
Pass Christian Miss.
(mailing address)


description of formations encountered	from to	
Clay	0	20
Sand	20	65
Clay	65	215
Sand	215	288

WELL LOCATION:
sec. 12 T 5 S R 12 E W
1 miles west of Sausier
(distance) (direction) (nearest town)

WELL PURPOSE: home
(home, irrigation, municipal, industrial)

- WELL COMPLETION DATA:
- (1) diameter (inches) 2
 - (2) total depth (feet) 288
 - (3) static water level (feet) 93 below top of ground.
 - (4) casing galv., 278' (material) (depth)
2" (size) if telescope see back.
 - (5) screen 10' , 278' (length) (depth to top)
2" , stainless steel (size) (material)
 - (6) pump 1 (HP) 7 (yield gpm)
elec. (type power)
 - (7) electric log no (yes or no)
(organization running log)
 - (8) how well bottom plugged BPU value

CODED

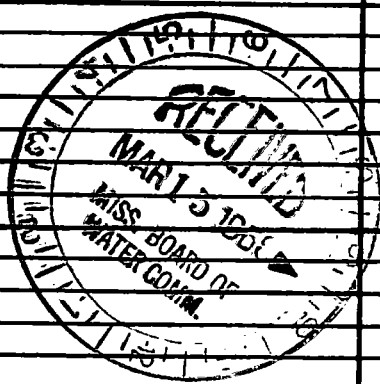

DRILLERS REMARKS:

If well telescopes please sketch and show depths.

GROUND LEVEL

		X	
Hand			
55		2	59

SECTION 23

Please indicate well location X.

ADDITIONAL INFORMATION

If more than one screen, show locations of each on sketch.