

**CODED**

MISSISSIPPI  
BOARD OF WATER COMMISSIONERS  
416 North State Street  
Jackson, Mississippi 39201

B-29  
Harrison Co.  
1-68

**WATER WELL DRILLERS LOG**  
NEIL LUMPKIN WELL DRILLING SERVICE

July 3 1968 date well completed  
P. O. BOX 117  
CARRIERS, MISS firm name  
Harrison county well located

LANDOWNER: St. Regis Paper Company

description of formations encountered	from	to
<u>Surface Clay</u>	<u>0</u>	<u>60</u>
<u>Fine silt</u>	<u>60</u>	<u>80</u>
<u>Hard blue clay</u>	<u>80</u>	<u>210</u>
<u>Fine to better sand</u>	<u>210</u>	<u>279</u>

(mailing address)  
WELL LOCATION: 5 S 12 W  
sec. 13 T-117 N R-11 W  
2 miles South of Stanger  
(distance) (direction) (nearest town)

WELL PURPOSE: Perched yard (honey)  
(home, irrigation, municipal, industrial)

- WELL COMPLETION DATA:
- (1) diameter (inches) 2"
  - (2) total depth (feet) 279'
  - (3) static water level (feet) 20 below top of ground.
  - (4) casing galv., 274'  
(material) (depth)  
2"  
(size) If telescope see back.
  - (5) screen 5'  
(length) (depth to top)  
2" St. Steel  
(size) (material)
  - (6) pump 1/2 (HP) (yield gpm)  
electric  
(type power)
  - (7) electric log No.  
(yes or no)
- (organization running log)
- (8) how well bottom plugged Johnson  
Back Pressure Valve


**CODED**

MISSISSIPPI  
BOARD OF WATER COMMISSIONERS  
JUL 25 1968

DRILLERS REMARKS:

If well telescopes please sketch and show depths.

GROUND LEVEL

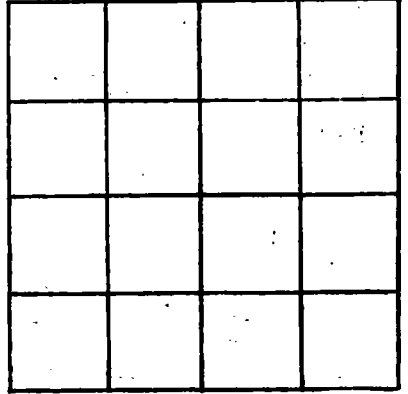

SECTION \_\_\_\_\_

Please indicate well location X.

ADDITIONAL INFORMATION

Lined area for additional information.

If more than one screen, show locations of each on sketch.