

CODED

MISSISSIPPI
BOARD OF WATER COMMISSIONERS
416 North State Street
Jackson, Mississippi 39201

WATER WELL DRILLERS LOG

Harrison
B 30
2-15-69

2-15-69 19 R. J. Moore HARRISON
date well completed firm name county well located

LANDOWNER:	description of formations encountered	from	to
<u>C. O. ALSTON</u>	<u>Red clay</u>	<u>0</u>	<u>26</u>
<u>25 Ave GULFPORT, MISS</u> (mailing address)	<u>Red SAND</u>	<u>26</u>	<u>30</u>
	<u>Blue clay</u>	<u>30</u>	<u>72</u>
WELL LOCATION:	<u>White RUSTY</u>		
sec. <u>1 T 5 N</u> <u>R 12 E</u>	<u>SAND</u>	<u>72</u>	<u>104</u>
<u>1/2</u> miles <u>N</u> of <u>SAULEN</u>			
(distance) (direction) (nearest town)			
WELL PURPOSE: <u>TRAILER</u> (home, irrigation, municipal, industrial)			
WELL COMPLETION DATA:			
(1) diameter (inches) <u>2"</u>			
(2) total depth (feet) <u>104</u>			
(3) static water level (feet) <u>50'</u> <u>below</u> top of ground.			
(4) casing <u>galv</u> <u>70'</u> (material) (depth)			
<u> </u> If telescope see back. (size)			
(5) screen <u>20'</u> <u>80'</u> (length) (depth to top)			
<u>2"</u> <u>S.S.</u> (size) (material)			
(6) pump <u>1</u> <u>100 HR</u> (HP) (yield gpm)			
<u> </u> (type power)			
(7) electric log <u>(yes or no)</u>			
<u> </u> (organization running log)			
(8) how well bottom plugged <u>B.W. valve</u>			
DRILLERS REMARKS:			


CODED

FEB 25 1969

MISS. BD. OF WATER COM.

If well telescopes please sketch and show depths.

GROUND LEVEL

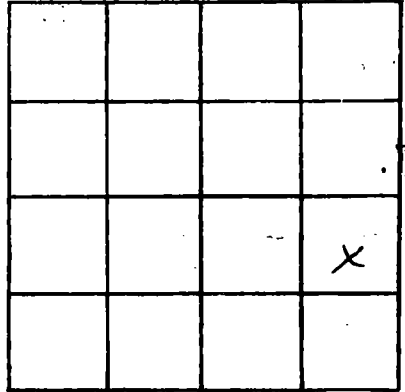

SECTION 1

Please indicate well location X.

ADDITIONAL INFORMATION

If more than one screen, show locations of each on sketch.