

Harrison  
B31  
9-25-68

MISSISSIPPI  
 BOARD OF WATER COMMISSIONERS  
 416 North State Street  
 Jackson, Mississippi 39201

**CODED**

WATER WELL DRILLERS LOG

Sept. 25-1968 19 Robiner Well Works Harrison  
 date well completed firm name county well located

LANDOWNER: George Alexander  
Yankus Road  
Osceola, Miss.  
 (mailing address)

description of formations encountered	from	to
<u>Yellow clay</u>	<u>0</u>	<u>50</u>
<u>Yellow sand</u>		<u>10</u>
<u>Blue clay</u>	<u>180</u>	<u>20</u>
<u>Blue sand</u>	<u>20</u>	<u>ft.</u>

WELL LOCATION:  
 sec 2 T 5 N R 12 E  
3 miles W of Osceola  
 (distance) (direction) (nearest town)

WELL PURPOSE: Home  
 (home, irrigation, municipal, industrial)

WELL COMPLETION DATA:

- (1) diameter (inches) 2 inch
- (2) total depth (feet) 268
- (3) static water level (feet) 50 below above top of ground.
- (4) casing Gal. 258 ft.  
 (material) (depth)
- 2 inch if telescope see back.  
 (size)
- (5) screen 10 ft. 10 ft.  
 (length) (depth to top)
- 2 inch, stainless  
 (size) (material) steel
- (6) pump 1 Horse 8  
 (HP) (yield gpm)
- Electric  
 (type power)
- (7) electric log no  
 (yes or no)
- (organization running log)
- (8) how well bottom plugged ball check


**CODED**

DRILLERS REMARKS:

1968

If well telescopes please sketch and show depths.

GROUND LEVEL

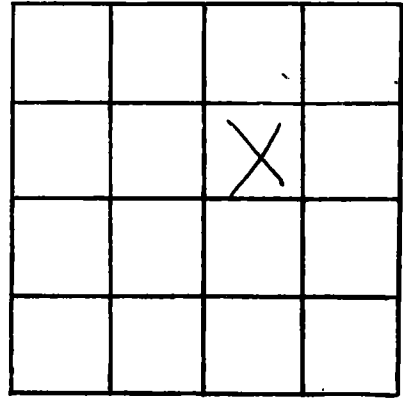

SECTION 2

Please indicate well location X.

ADDITIONAL INFORMATION

---

---

If more than one screen, show locations of each on sketch.