

HARRISON  
 B33  
 5-21-69

MISSISSIPPI  
 BOARD OF WATER COMMISSIONERS  
 416 North State Street  
 Jackson, Mississippi 39201

CODED

WATER WELL DRILLERS LOG

5/21/69 1969 Coastal Drilling Co. Harrison  
 date well completed firm name county well located

LANDOWNER: Mr R O  
 Wedgeworth Rt 1 24284  
 Sumner, Miss  
 (mailing address)

description of formations encountered	from	to
Red Clay	1	15
White Sand	15	47
Red Clay	47	60
Sandy Clay	100	147
Very hard clay	147	206
Very coarse sand	286	304

WELL LOCATION:  
 sec. 15 T 5 N R 12 E  
 S W  
 2 miles SW of Sumner  
 (distance) (direction) (nearest town)

WELL PURPOSE: Home  
 (home, irrigation, municipal, industrial)

WELL COMPLETION DATA:  
 (1) diameter (inches) 2"  
 (2) total depth (feet) 314'  
 (3) static water level (feet) \_\_\_\_\_ below above top of ground.  
 (4) casing 2" (material), 214' (depth)

CODED

(size) If telescope see back.  
 (5) screen 10' (length), (depth to top)  
 2" (size), SS (material)  
 (6) pump 1/2 HP (HP), 16' (yield gpm)  
 Ele (type power)

(7) electric log \_\_\_\_\_ (yes or no)

(organization running log)

(8) how well bottom plugged good


DRILLERS REMARKS:  
 [Signature]

JUL 31 1969

MISS. BD. OF  
 WATER COMM.

If well telescopes please sketch and show depths.

GROUND LEVEL

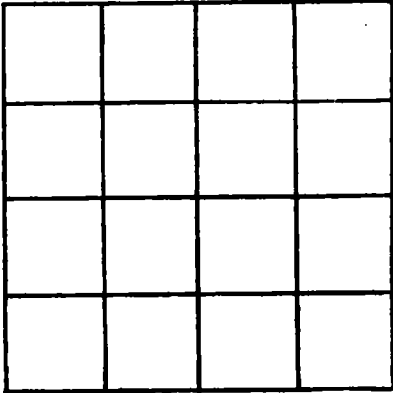

SECTION \_\_\_\_\_

Please indicate well location X.

ADDITIONAL INFORMATION

If more than one screen, show locations of each on sketch.