

CODED

MISSISSIPPI  
BOARD OF WATER COMMISSIONERS  
416 North State Street  
Jackson, Mississippi 39201

WATER WELL DRILLERS LOG

Harrison  
B34  
2-23-70

2-23 1970 Parwell Anderson Harrison  
date well completed firm name county well located

LANDOWNER: MARVIN G FULTON  
P.O. Drawer X Ocean Springs  
(mailing address)

description of formations encountered	from	to
Topsoil	0	5
Red clay	5	24
White clay	24	30
Blue clay	30	61
Coarse Sand	61	75

WELL LOCATION:  
sec 27 T 4 R 12  
miles \_\_\_\_\_ of \_\_\_\_\_  
(distance) (direction) (nearest town)

WELL PURPOSE: Home  
(home, irrigation, municipal, industrial)

- WELL COMPLETION DATA:
- (1) diameter (inches) 2
  - (2) total depth (feet) 75
  - (3) static water level (feet) 68 below top of ground.
  - (4) casing Plastic, 69  
(material) (depth)
  - (size) if telescope see back.
  - (5) screen 6', 69  
(length) (depth to top)
  - 2", Plastic  
(size) (material)
  - (6) pump 1 11  
(HP) (yield gpm)
  - Elect  
(type power)
  - (7) electric log \_\_\_\_\_  
(yes or no)
  - \_\_\_\_\_ (organization running log)
  - (8) how well bottom plugged \_\_\_\_\_

CODED


MAR 6 - 1970

MISS. BD. OF  
WATER COMM.

DRILLERS REMARKS:

If well telescopes please sketch and show depths.

GROUND LEVEL

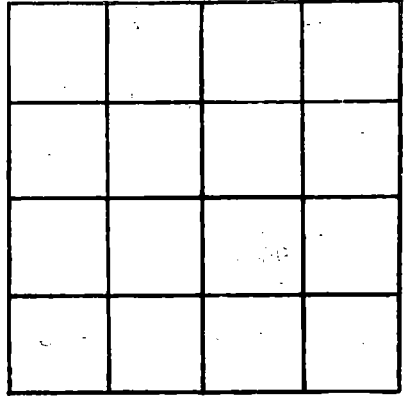

SECTION \_\_\_\_\_

Please indicate well location X.

ADDITIONAL INFORMATION

If more than one screen, show locations of each on sketch.