

HARRISON
B35
10-12-70

MISSISSIPPI
 BOARD OF WATER COMMISSIONERS
 416 North State Street
 Jackson, Mississippi 39201

CODED

WATER WELL DRILLERS LOG

OCT 12 1970 R T Moore HARRISON
 date well completed firm name county well located

LANDOWNER: J.R. ALEXANDER

description of formations encountered

from

to

Lot #1 Bldg 1

Coalsport Miss
 (mailing address)

TOP Soil	0	10
White Clay	10	70
Blue Clay	70	220
FINE Sand	220	235
Blue Clay	235	270
GRAY SAND	270	304

WELL LOCATION:

sec. 4 T. 5 N. R. 12 E.
 (S) (W)
2 1/2 miles SW of SANDERS
 (distance) (direction) (nearest town)

WELL PURPOSE:

(home) Irrigation, municipal, industrial)

WELL COMPLETION DATA:

- diameter (inches) 2"
- total depth (feet) 304
- static water level (feet) 110' ^{below} above top of ground.
- casing 2 1/2" 294'
 (material) (depth)
 (size) If telescope see back.
- screen 2x10 294'
 (length) (depth to top)
2" SS
 (size) (material)
- pump 1 600 GPM
 (HP) (yield gpm)
E
 (type power)
- electric log (yes or no)
 (organization running log)
- how well bottom plugged Yes

CODED


OCT 15 1970

MISS. BOARD OF WATER COMMISSIONERS
 WAIVED

DRILLERS REMARKS:

If well telescopes please sketch and show depths.

GROUND LEVEL

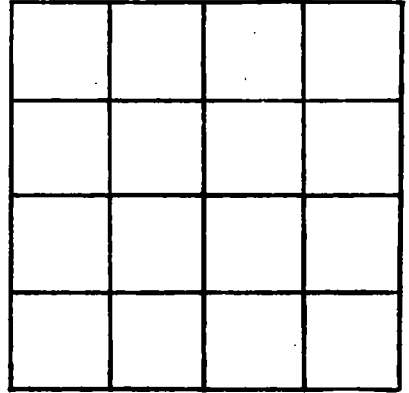

SECTION _____

Please indicate well location X.

ADDITIONAL INFORMATION

If more than one screen, show locations of each on sketch.